

- SUPPORT NOTES:
- 1) SEE SHT. 11 FOR GENERAL NOTES & TYP. DETAILS.
 - 2) ALL SLAB ANCHORS SHALL BE LOCATED AT MID-DEPTH OF SLAB.
 - 3) SLAB THICKNESS IS 8" TYP. UNO.
 - 4) HEIGHTS ARE CHAIR HEIGHTS UNO. WITH A CGS
 - 5) SB = SLAB BOLSTER

KPFF Fax: 2066228130 Jul 8 2008 11:23 P. 02

Washington Hanover LLC
1601 8th Ave.
Seattle, WA 98101
Ph: 206-422-6855 Fax: 206-422-6190

To: Nick Pett
KPFF Consulting Engineers
1601 8th Ave.
Suite 1900
Seattle, WA 98101
Ph: 206-422-6855 Fax: 206-422-6190

RFI # 483
Date: 7/16/2008
Job: WA-011 Olive Way High-Rise
Phone:

CC: Holly Carroll (Construction Administration), Emily Bartha (Washington Hanover LLC), Penn DuBois (Washington Hanover LLC), Ryan Corbett (Washington Hanover LLC), Danny Fennel (Hanover P.S. & Partners), Dan Javert (Washington Hanover LLC), Craig Hart (Washington Hanover LLC), Kevin Blawieck (Washington Hanover LLC), Jeff Johnson (Washington Hanover LLC), Neil Corbett (WA-HANOVER LLC), Mike Yulian (Washington Hanover LLC)

Subject: Level 27 and 28 bonded tendons (BAK #142)

Drawings: 22.279, 22.280
Cost Impact: None
New Revision: Schedule Impact: None

Request: Please provide the missing force information for level 27 at grid 6, 7 and 8, 10, and for level 28 at grid 6, 7, and 7.3. Please provide the missing profile information for levels 27 and 28 at 8.8.

Requested by: Evan Coatsman
Originator RFI #:

Response: SEE ATTACHED SKETCHES EX. 1, 2 AND 3.

Answered by: Nick Pett
Date: 7/16/08
Company: KPFF

Page 1 of 1

CONFIRMS TO DESIGN CONCEPT
CONFIRMS TO DESIGN CONCEPT WITH REVISIONS AS SHOWN
NON-CONFORMING
REVISE & RESUBMIT

THIS SUB DRAWING HAS BEEN REVIEWED FOR GENERAL CONFORMANCE WITH DESIGN CONCEPT ONLY AND DOES NOT RELIEVE THE PUBLIC OR BOOK OF RESPONSIBILITY FOR CONFORMANCE WITH DESIGN DRAWINGS AND SPECIFICATIONS. ALL OF WHICH HAVE PRECEDENCE OVER THIS SUB DRAWING.

By: COL Date: 6/10/08

D2365-10-00

Review is for general compliance with the contract documents for this project only. Subcontractor or supplier is responsible for emissions, quantities, dimensions, field conditions, coordination with all trades, and information pertaining to fabrication processes or construction techniques. Review shall not relieve subcontractor or supplier from responsibility for errors, omissions or deviation from contract documents. Stamped submission does not constitute a change order.

By: N6 Date: 6/17/08


SAK SUBMITTAL REVIEW
REVIEW BY SAK CONSTRUCTION IS FOR DESIGN INTENT ONLY. SUBCONTRACTOR AND/OR SUPPLIER IS RESPONSIBLE FOR THE DIMENSIONS, QUANTITIES AND FULL COMPLIANCE WITH THE REQUIREMENTS OF THE CONTRACT DOCUMENTS. REVIEW BY SAK CONSTRUCTION DOES NOT RELIEVE THE SUBCONTRACTOR AND/OR SUPPLIER FROM RESPONSIBILITY REQUIRED BY THE TERMS AND CONDITIONS OF THEIR CONTRACT WITH SAK CONSTRUCTION.

REVIEWED
REVIEWED REUSE AS NOTED
DISAPPROVED: RESUBMIT

By: [Signature] Date: 6/14/2008

CITY OF SEATTLE
DEPT. OF PLANNING AND DEVELOPMENT
JUL 8 2008
APPROVED Subject to Errors and Omissions By
[Signature]
MARTIN ANCHUT

RECEIVED
JUL 15 2008
PLANNING & DEVELOPMENT
6/14/2008

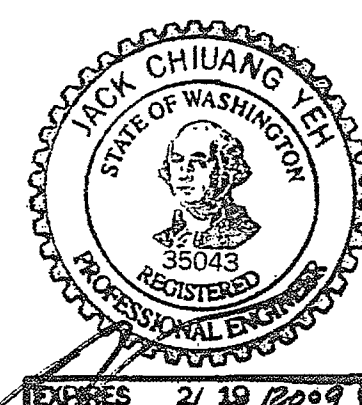

ISSUED FOR
JUNE 13, 2008
APPROVAL
RPS, INC. CLAREMONT, CA


REINFORCING, POST-TENSIONING SERVICES, INC.

715 100TH STREET SE A2
EVERETT, WA 98208
Phone (425) 955-3531 Fax (425) 955-3549

POST SUB
April 6/22/08
Post-tensioning shop drawings.
Pawant0091100

Full C
CHRL
\$352,729.56
309 OLIVE WAY
Use
2 of 3

Date 0
Scale 1/4"
Drawn
Job
Sheet
PT-
of

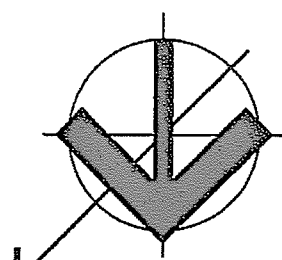

- CABLE NOTES:
- SEE SHT. #1 FOR GENERAL NOTES & TYP. DETAILS.
 - ALL SLAB ANCHORS SHALL BE LOCATED AT MID-DEPTH OF SLAB.
 - SLAB THICKNESS IS 8" TYP. UNO.
 - AT LEAST TWO TENDONS SHALL PASS THROUGH EACH COLUMN IN EACH DIRECTION.

KPFF Fax: 2066228130 Jul 8 2008 11:23 P.02

Washington Hanover LLC
5407 East Main, Suite 1000
Houston, TX 77057
Ph: (713) 960-4700

To: Nick Pett
KPFF Consulting Engineers
1601 10th Ave.
Suite 1000
Seattle, WA 98101
Ph: 206-455-5858 Fax: 206-455-8150

CC: Kelly Carroll (Construction Administration), Emily Statton (Washington Hanover LLC), Penn D'Adda (Washington Hanover LLC), Evan Cochran (Washington Hanover LLC), Danny Fernald (Planner P.A. Inc., Permitting), Greg Jansen (Washington Hanover LLC), Chris Hart (Washington Hanover LLC), Kevin Elmside (Washington Hanover LLC), Jeff Johnson (Washington Hanover LLC), Nick Garza (OIA HANDOVER LLC), Mike Vetter (Washington Hanover LLC)

Subject: Level 27 and 28 bonded tendons (SAC #142)

Drawing: 52.27P, 02.27P
Cost Impact: None
Spec Section: Schedule Impact: None


RFI # 483
Date: 7/8/2008
Job: WA-011 Olive Way High-Rise
Phase:

Requested by: Evan Cochran
Date Required: 7/23/2008

Response: SEE ATTACHED SHEETS SK-1, 2 AND 3.

Approved by: Nick Pett
Company: KPFF
Date: 7/26/08

Page 1 of 1

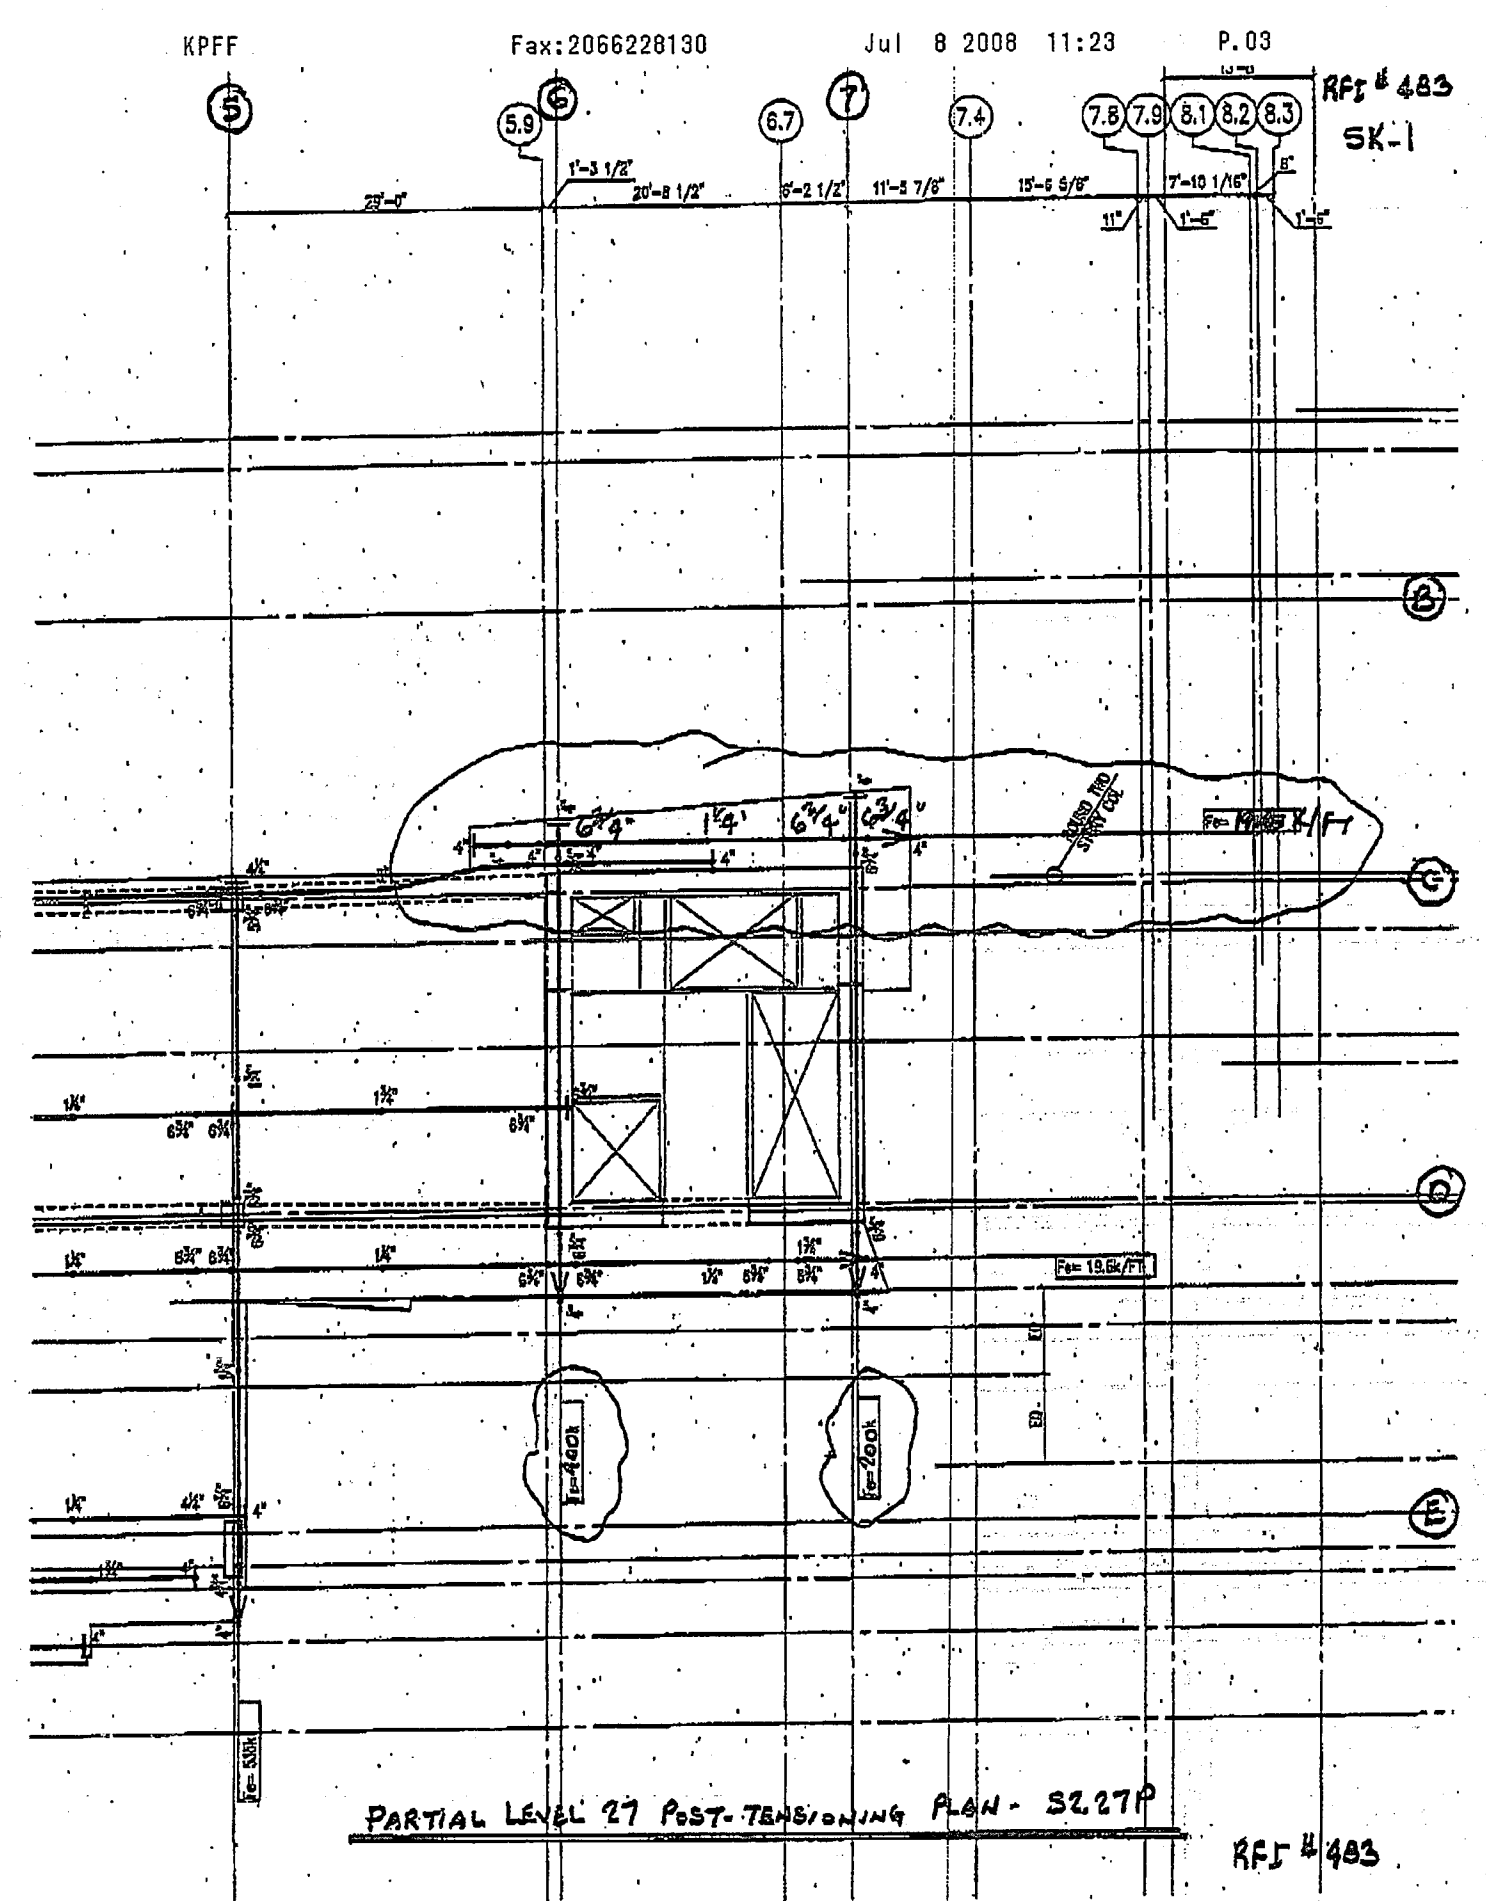


RECEIVED
JUL 10 2008
PLANNING
Planning Division

CITY OF SEATTLE
DEPT. OF PLANNING AND DEVELOPMENT
JUL 8 2008
APPROVED Subject to Errors and Omissions By
MARTIN ANDERSON

SAK SUBMITTAL REVIEW
REVIEW BY SAK CONSTRUCTION IS FOR DESIGN INTENT ONLY.
SUBCONTRACTOR AND/OR SUPPLIER IS RESPONSIBLE FOR DIMENSIONS, QUANTITIES AND FULL COMPLIANCE WITH THE REQUIREMENTS OF THE CONTRACT DOCUMENTS. REVIEW BY SAK CONSTRUCTION DOES NOT RELIEVE SUBCONTRACTOR AND/OR SUPPLIER OF THE RESPONSIBILITY REQUIRED BY THE TERMS AND CONDITIONS OF THEIR CONTRACT WITH SAK CONSTRUCTION.

REVIEWED: ☒ REVIEWED REVISION AS NOTED
DISAPPROVED: RESUBMIT

By: AK Date: 6/17/08

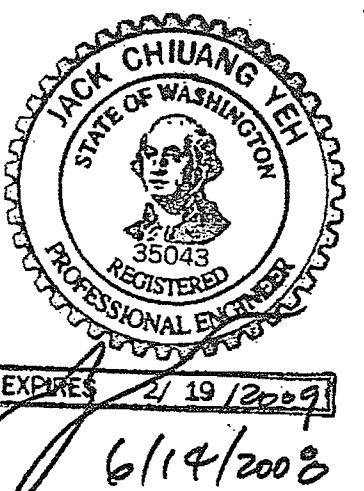

ISSUED FOR
JUNE 13, 2008
APPROVAL
RPS, INC. CLAREMONT, CA

☒ CONFORMS TO DESIGN CONCEPT
☒ CONFORMS TO DESIGN CONCEPT WITH REVISIONS AS SHOWN
☐ NON-CONFORMING

REVISOR & RESUBMIT

THIS DRAWING HAS BEEN REVIEWED FOR GENERAL CONFORMANCE WITH DESIGN CONCEPT ONLY AND DOES NOT RELIEVE THE FABRICATOR VENDOR OF RESPONSIBILITY FOR CONFORMANCE WITH DESIGN DRAWINGS AND SPECIFICATIONS. ALL OF WHICH HAVE PRIORITY OVER THIS SHOP DRAWING.

By: CE Date: 6/17/08

03365-10-00

Review is for general compliance with the contract documents for this project only. Subcontractor or supplier is responsible for omissions, quantities, dimensions, field conditions, coordination with all trades, and information pertaining to fabrication processes or construction techniques. Review shall not relieve subcontractor or supplier from responsibility for errors, omissions or deviation from contract documents. Stamped submission does not constitute a change order.

Washington Hanover LLC
By: NK Date: 6/17/08


TENDON LAYOUT LEVEL 27

OLIVIAN TOWER




REINFORCING, POST-TENSIONING SERVICES, INC.

715 100TH STREET SE A2
EVERETT, WA 98208
Phone (425) 355-3531 Fax (425) 355-3549


Date 03/28/08
Scale 1/8"=1'-0"
Drawn TMV
Job 07043
Sheet PT-29
of sheets

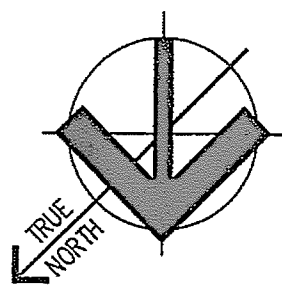

- SUPPORT NOTES:
- 1) SEE SHT. #1 FOR GENERAL NOTES & TYP. DETAILS.
 - 2) ALL SLAB ANCHORS SHALL BE LOCATED AT MID-DEPTH OF SLAB.
 - 3) SLAB THICKNESS IS 8" TYP. UNO.
 - 4) HEIGHTS ARE CHAIR HEIGHTS UNO. WITH A CGS
 - 5) SB = SLAB BOLSTER

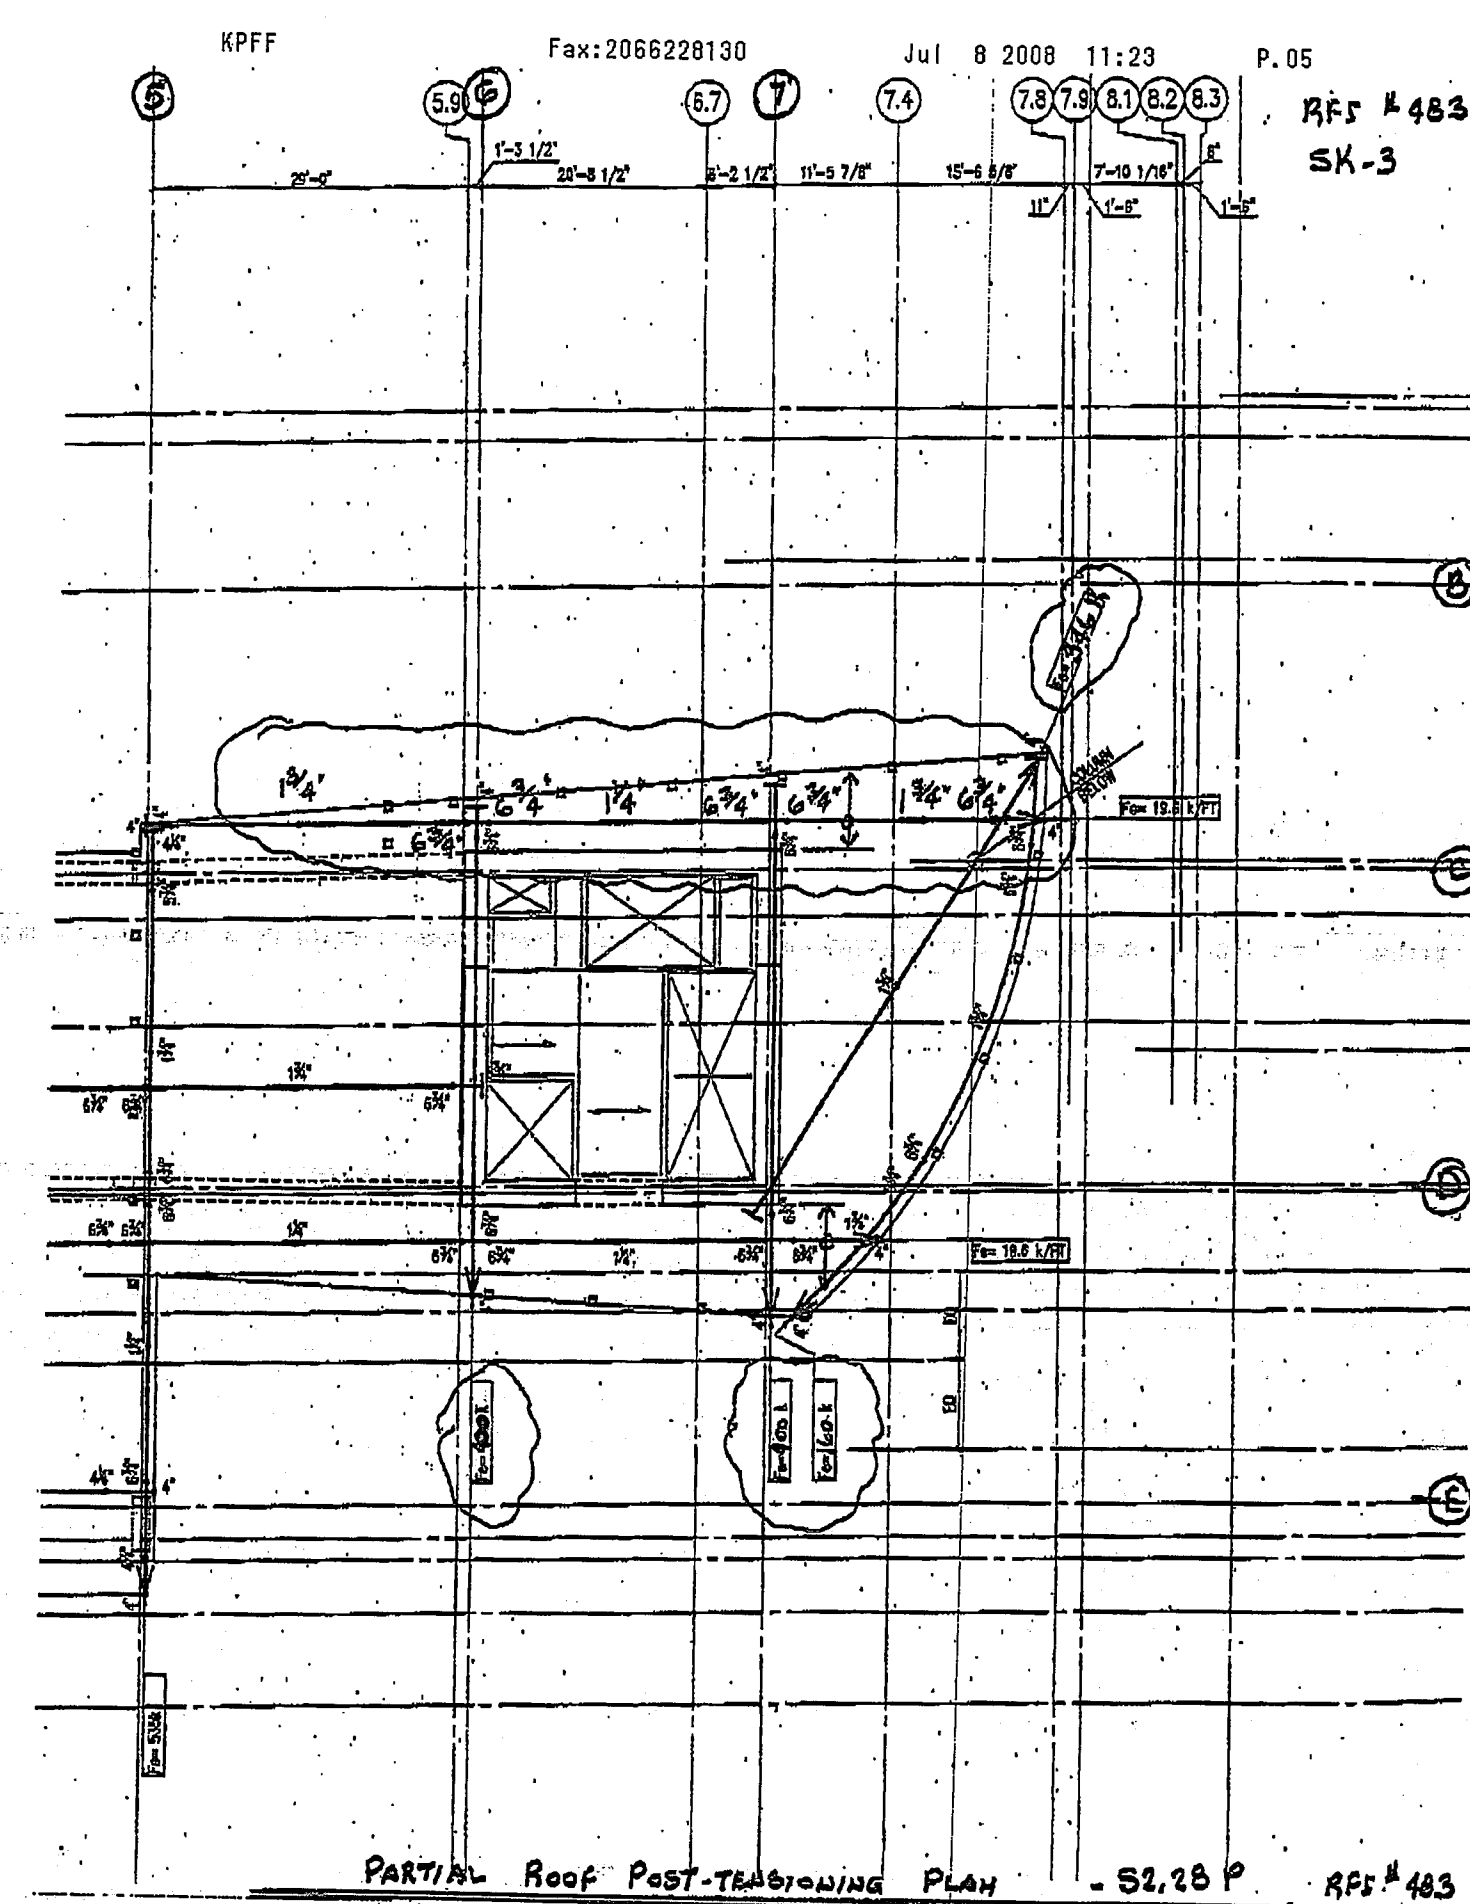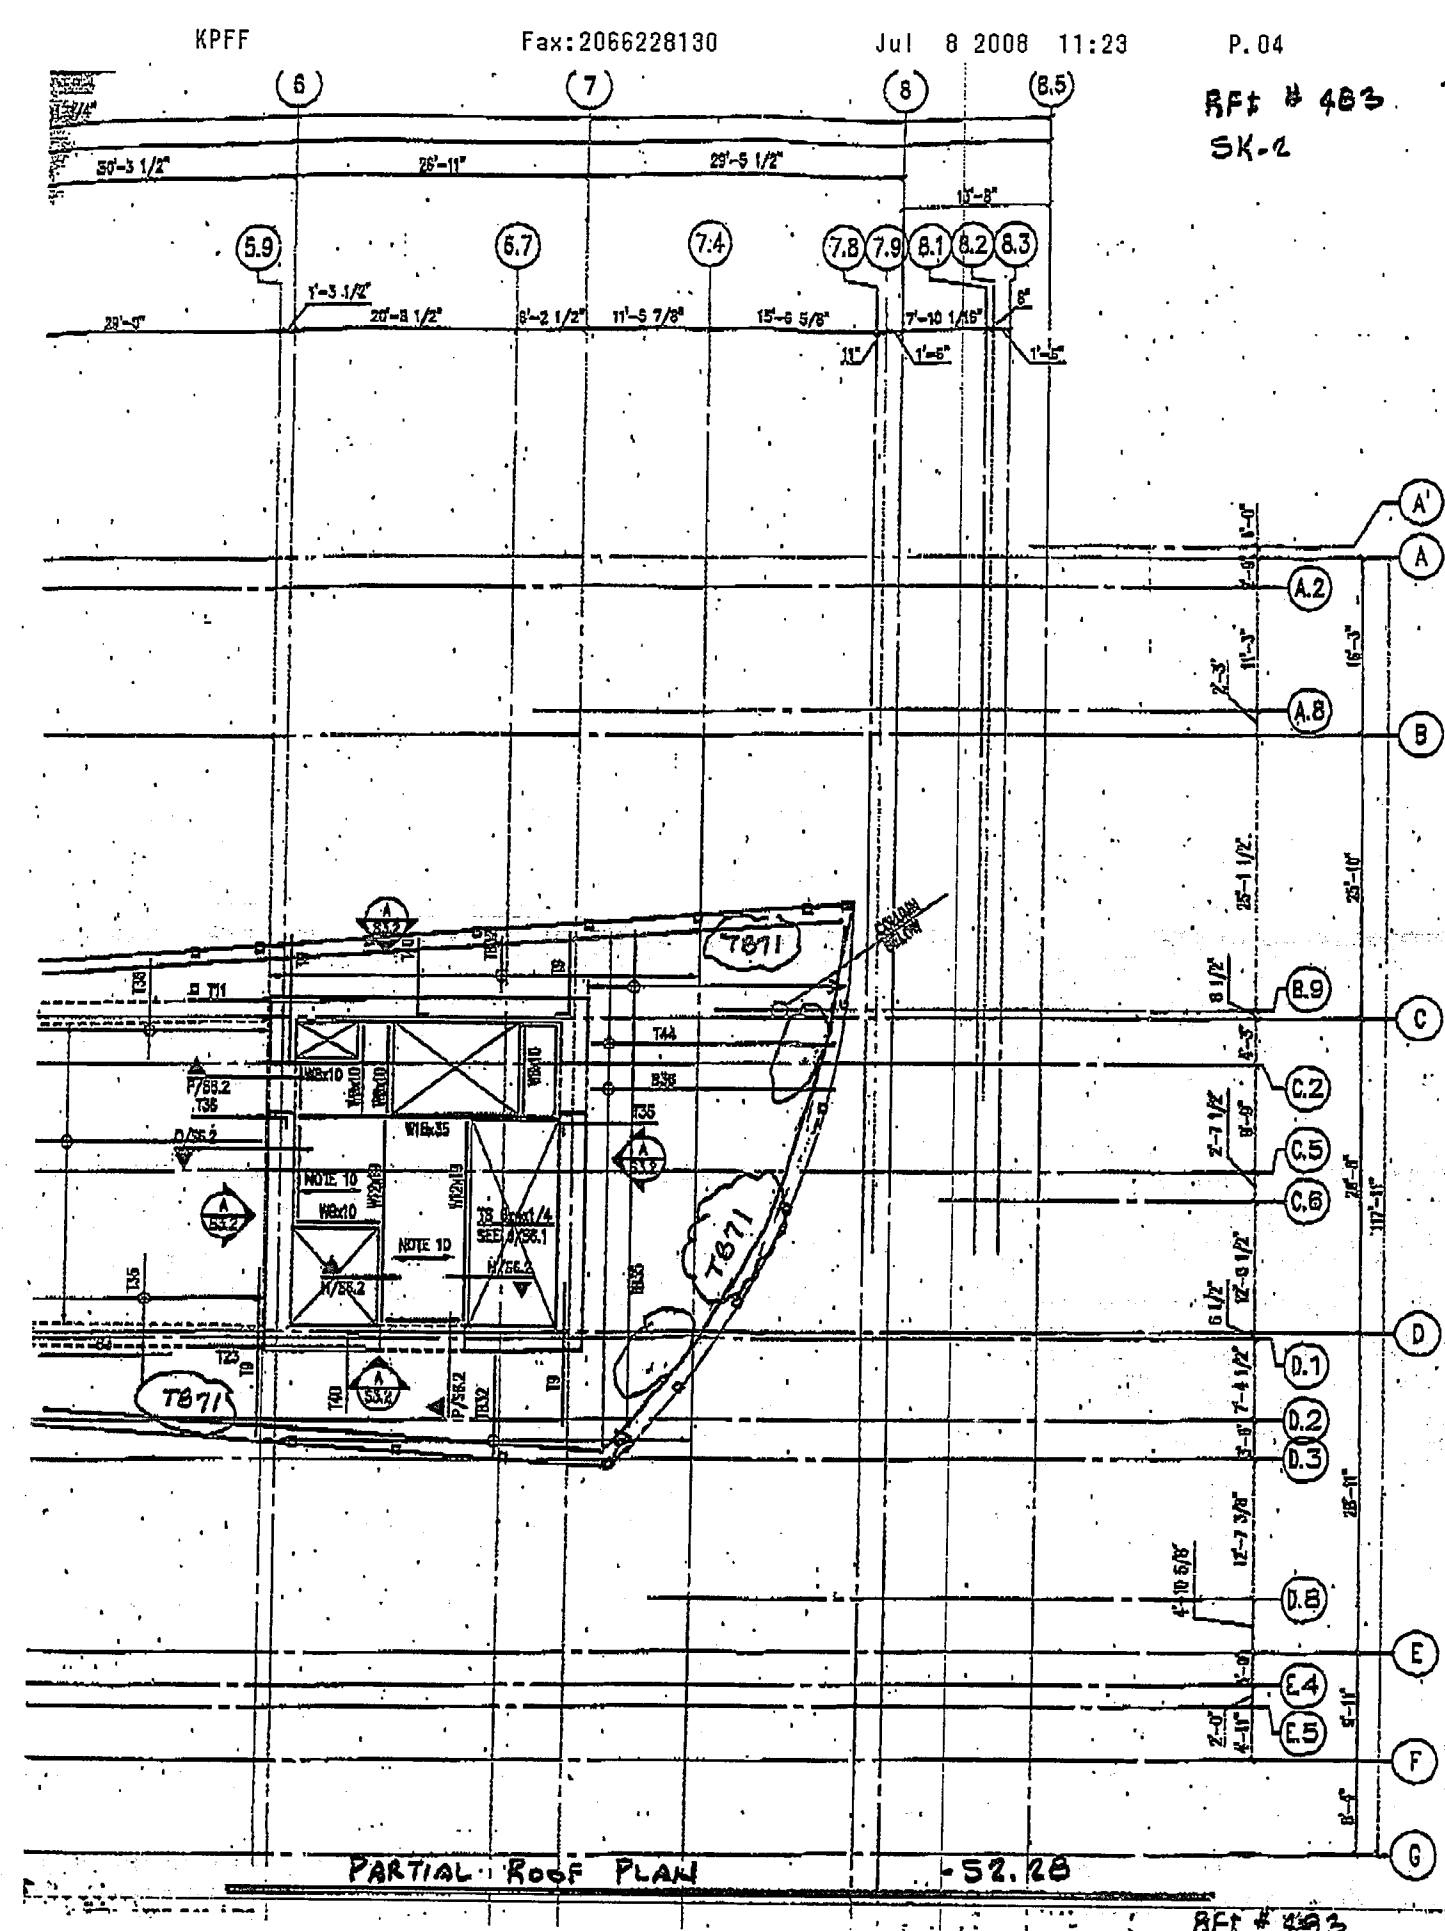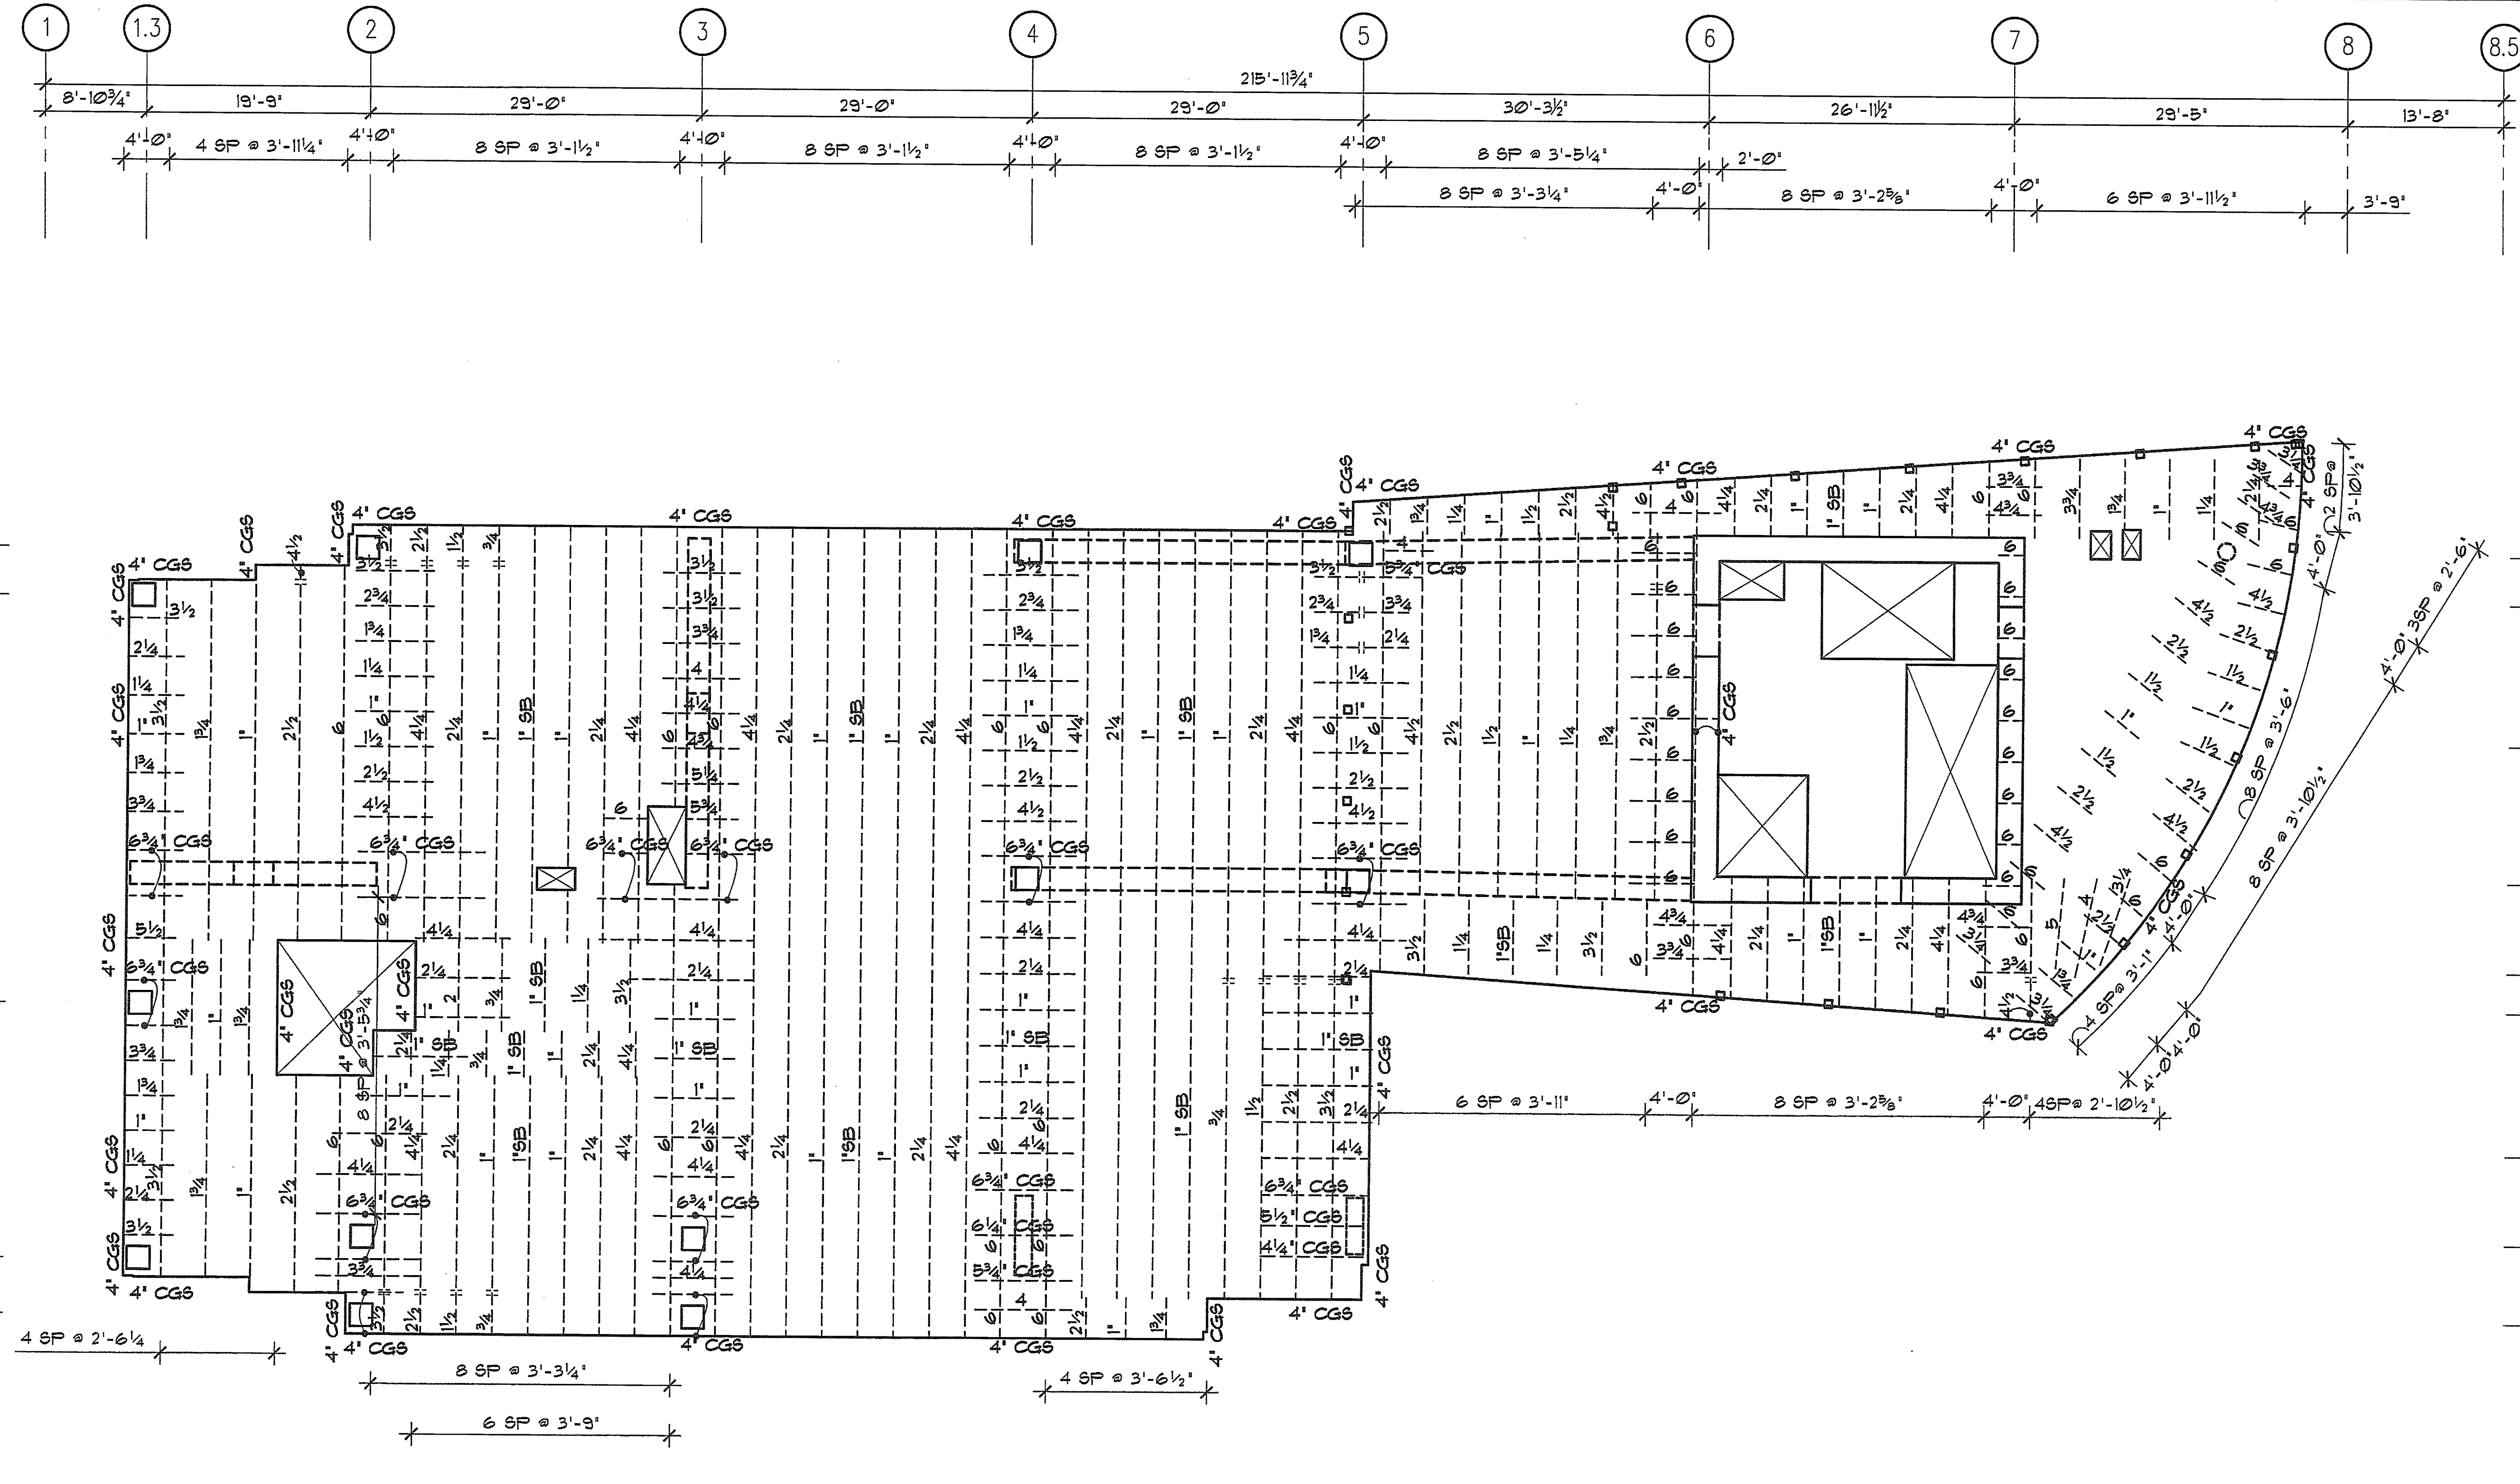

GRIDLINE 4
GRIDLINE 5
GRIDLINE 6
GRIDLINE 7

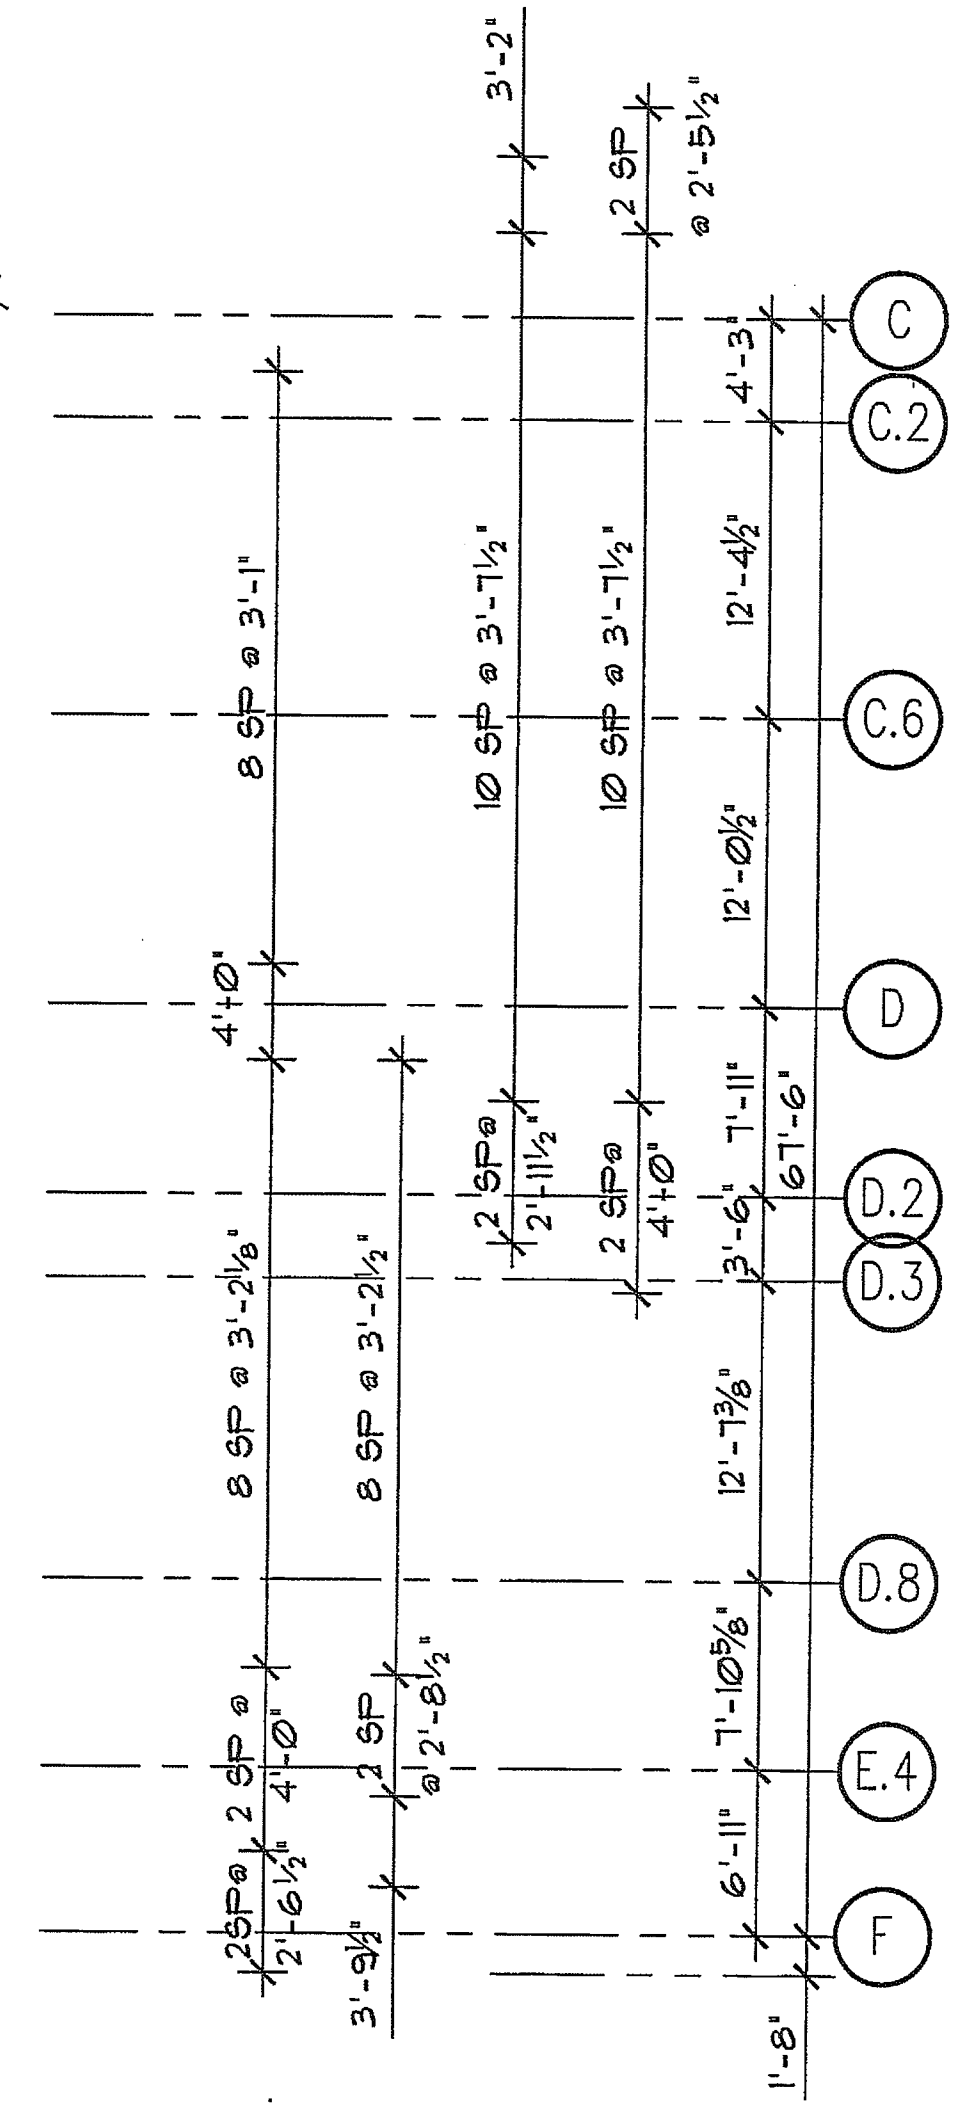

CONFORMS TO DESIGN CONCEPT
CONFORMS TO DESIGN CONCEPT WITH REVISIONS AS SHOWN
NON-CONFORMING
REVISE & RESUBMIT
THIS DRAWING HAS BEEN REVIEWED FOR GENERAL CONFORMANCE WITH DESIGN CONCEPT ONLY AND DOES NOT RELIEVE THE FABRICATOR FROM RESPONSIBILITY FOR CONFORMANCE WITH DESIGN DRAWINGS AND SPECIFICATIONS. ALL OF WHICH HAVE PROBABLY OVER THIS DRAWING.

BY: CGL DATE: 6/22/08

03365-10-00
Review is for general compliance with the contract documents for this project only. Subcontractor or supplier is responsible for emissions, quantities, dimensions, field conditions, coordination with all trades, and information pertaining to fabrication processes or construction techniques. Review shall not relieve subcontractor or supplier from responsibility for errors, omissions or deviation from contract documents. Stamped submission does not constitute a change order.


Washington Hanover LLC
By: N6 Date: 6/17/08

SAK SUBMITTAL REVIEW
REVIEW BY SAK CONSTRUCTION IS FOR DESIGN INTENT ONLY.
SUBCONTRACTOR AND/OR SUPPLIER IS RESPONSIBLE FOR DIMENSIONS, QUANTITIES AND FULL COMPLIANCE WITH THE REQUIREMENTS OF THE CONTRACT DOCUMENTS. REVIEW BY SAK CONSTRUCTION DOES NOT RELIEVE THE SUBCONTRACTOR AND/OR SUPPLIER FROM RESPONSIBILITY REQUIRED BY THE TERMS AND CONDITIONS OF THEIR CONTRACT WITH SAK CONSTRUCTION.

REVIEWED
REVIEWED REVERSE AS NOTED
DISAPPROVED: RESUBMIT


CITY OF SEATTLE
DEPT. OF PLANNING AND DEVELOPMENT
JUL 8 2008
APPROVED Subject to Errors and Omissions By
MARTIN ANDICH

RECEIVED
JUL 10 2008
PLANNING DEPARTMENT

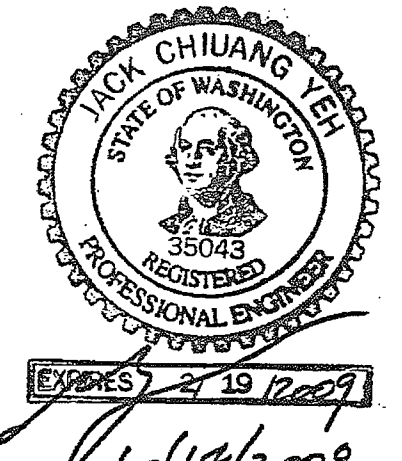

ISSUED FOR
JUNE 13, 2008
APPROVAL
RPB, INC. CLAREMONT, CA




REINFORCING, POST-TENSIONING
SERVICES, INC.
745 100TH STREET SE A2
EVERETT, WA 98206
Phone (425)555-3531
Fax (425)555-3549

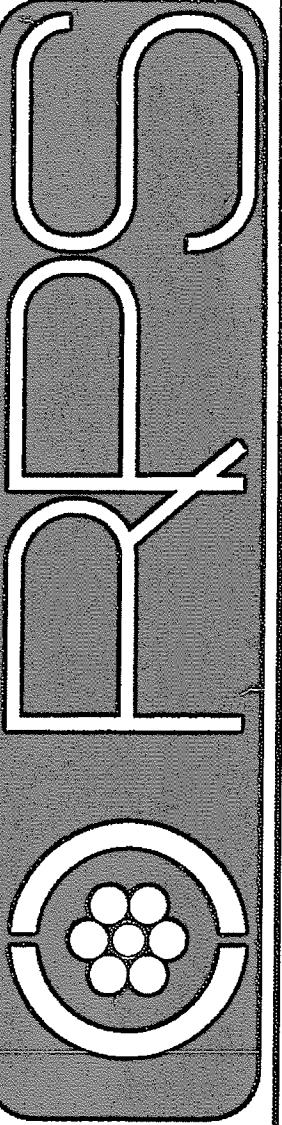

Date 03/28/08
Scale 1/8"=1'-0"
Drawn TMV
Job 07043
Sheet
PT-30
of sheets

SUPPORT BAR PLAN ROOF
OLIVIAN TOWER

DESCRIPTION	DATE	REV.

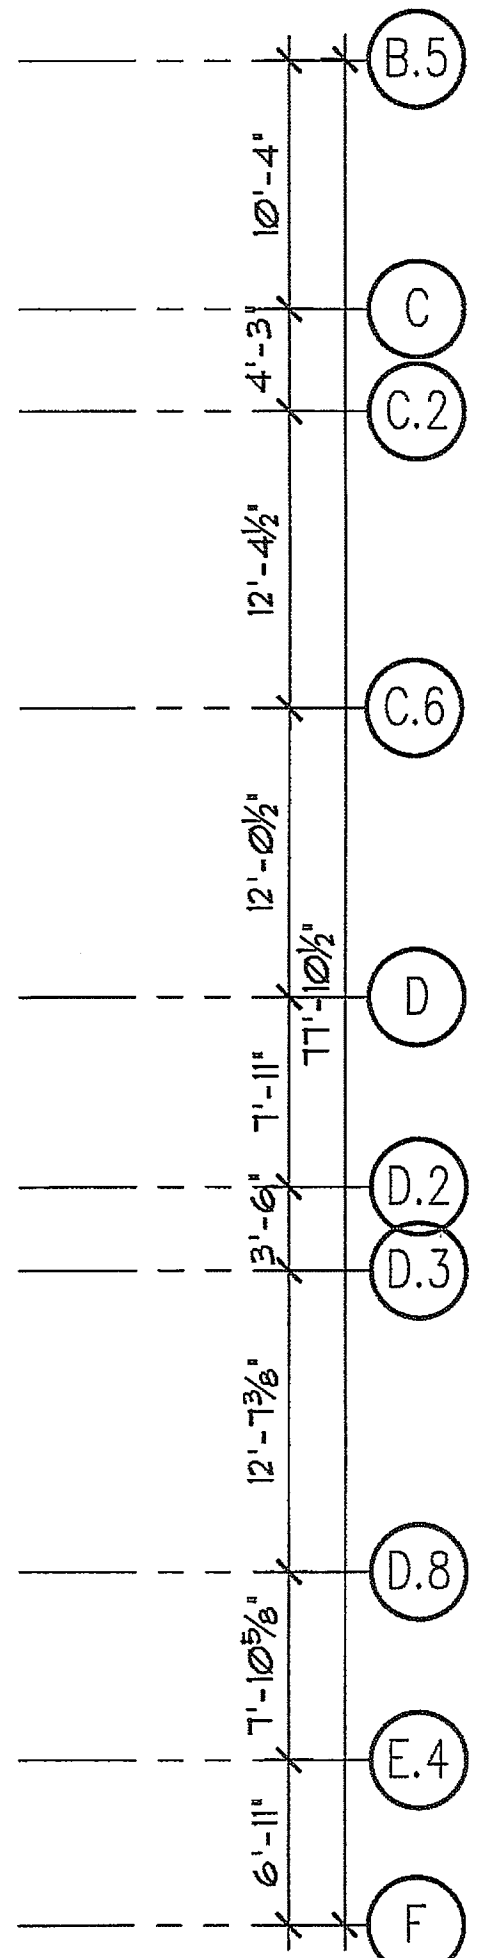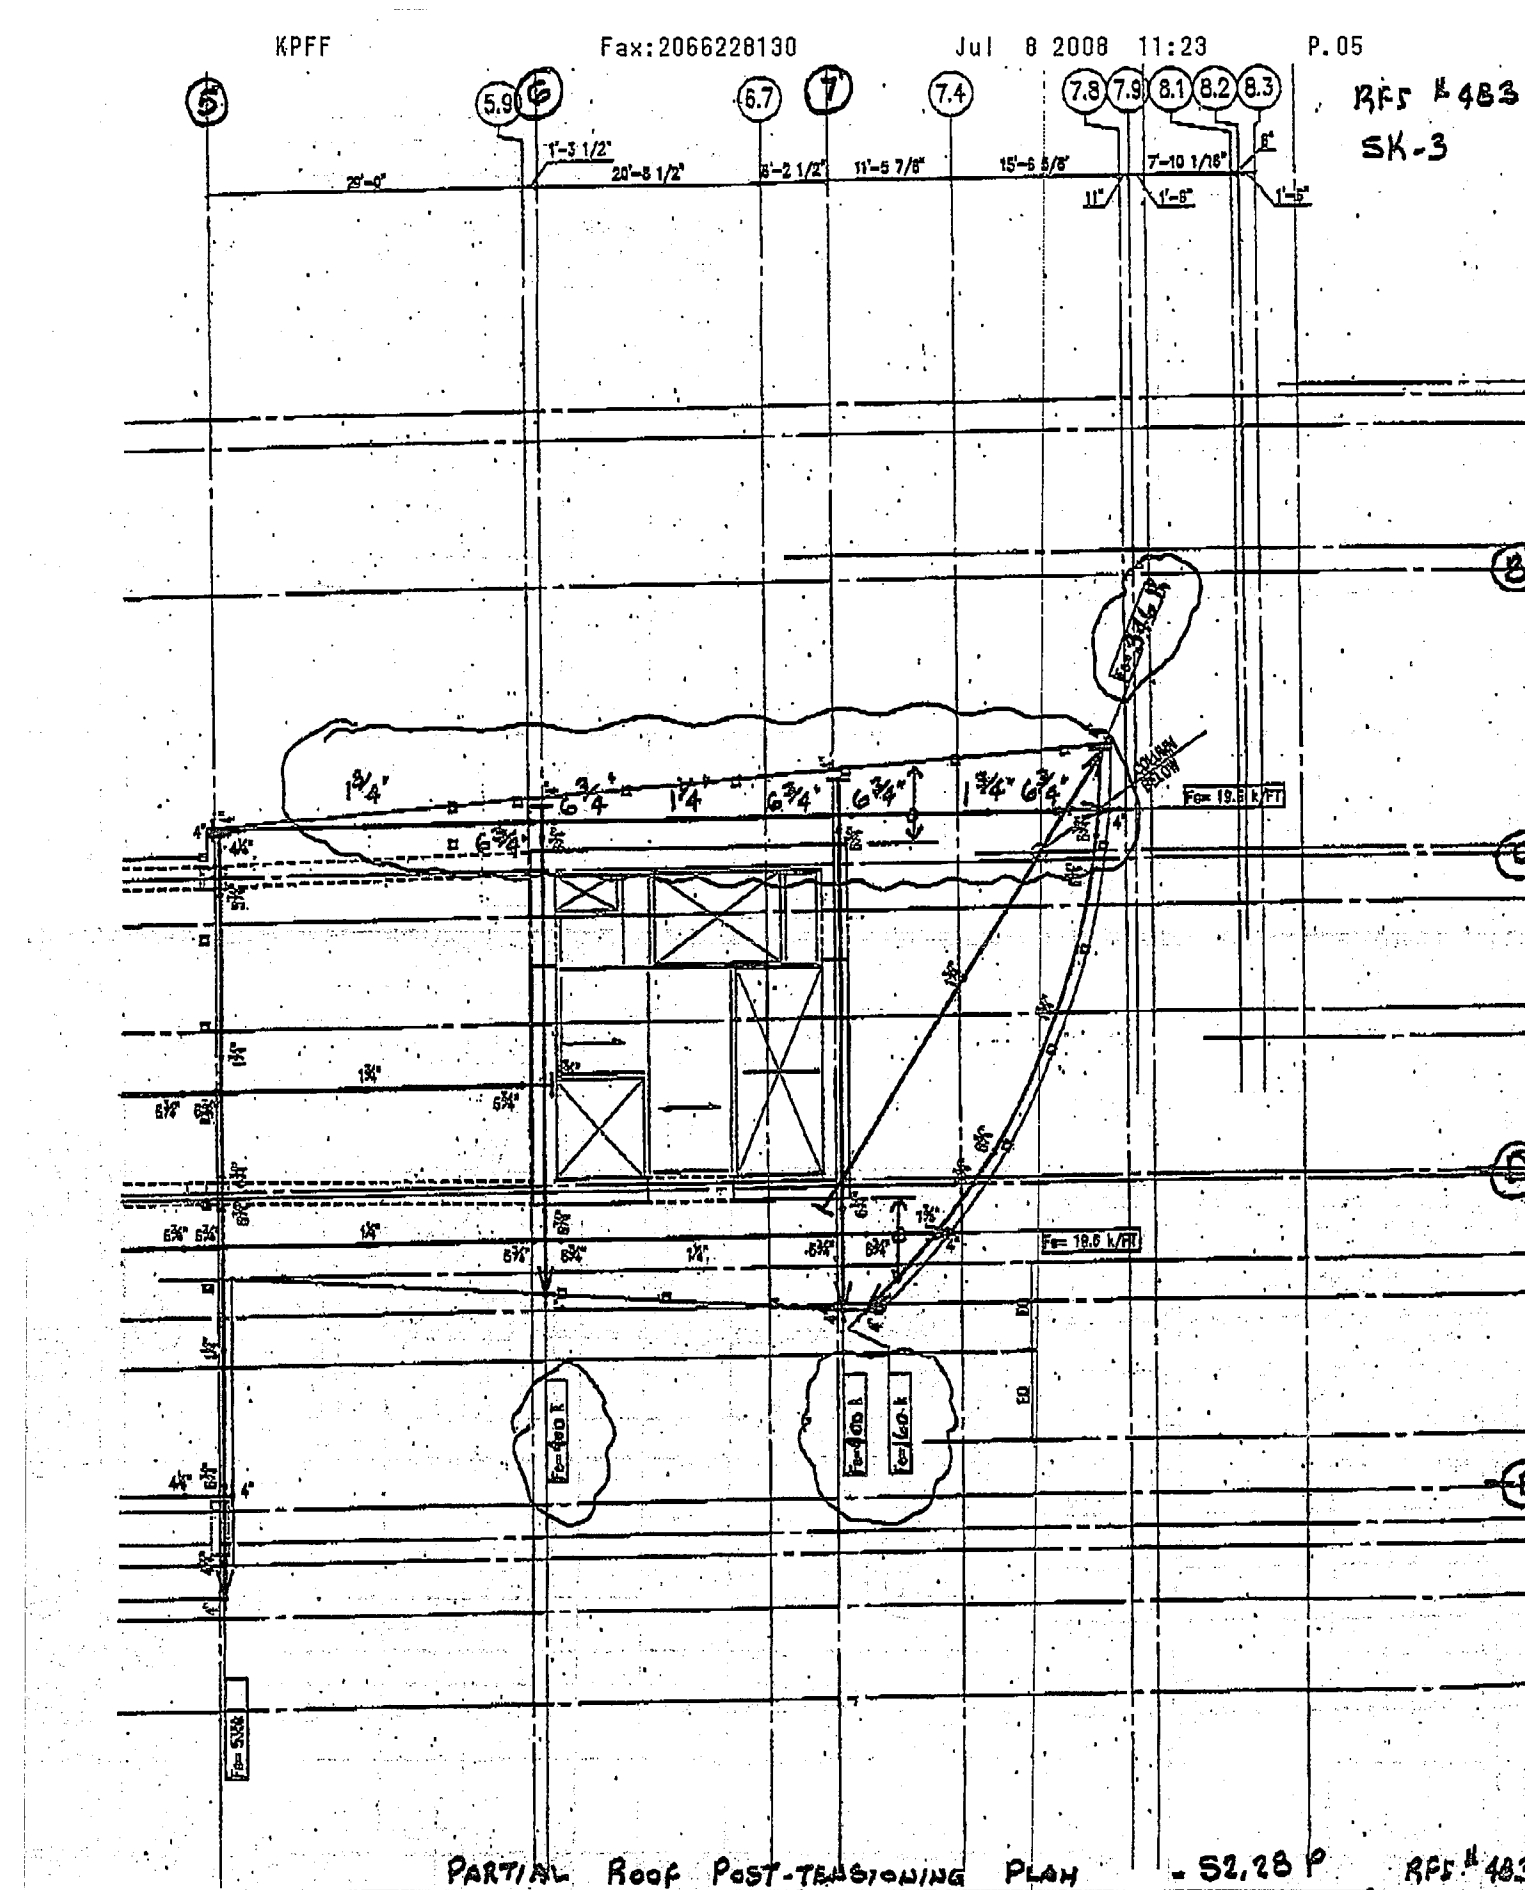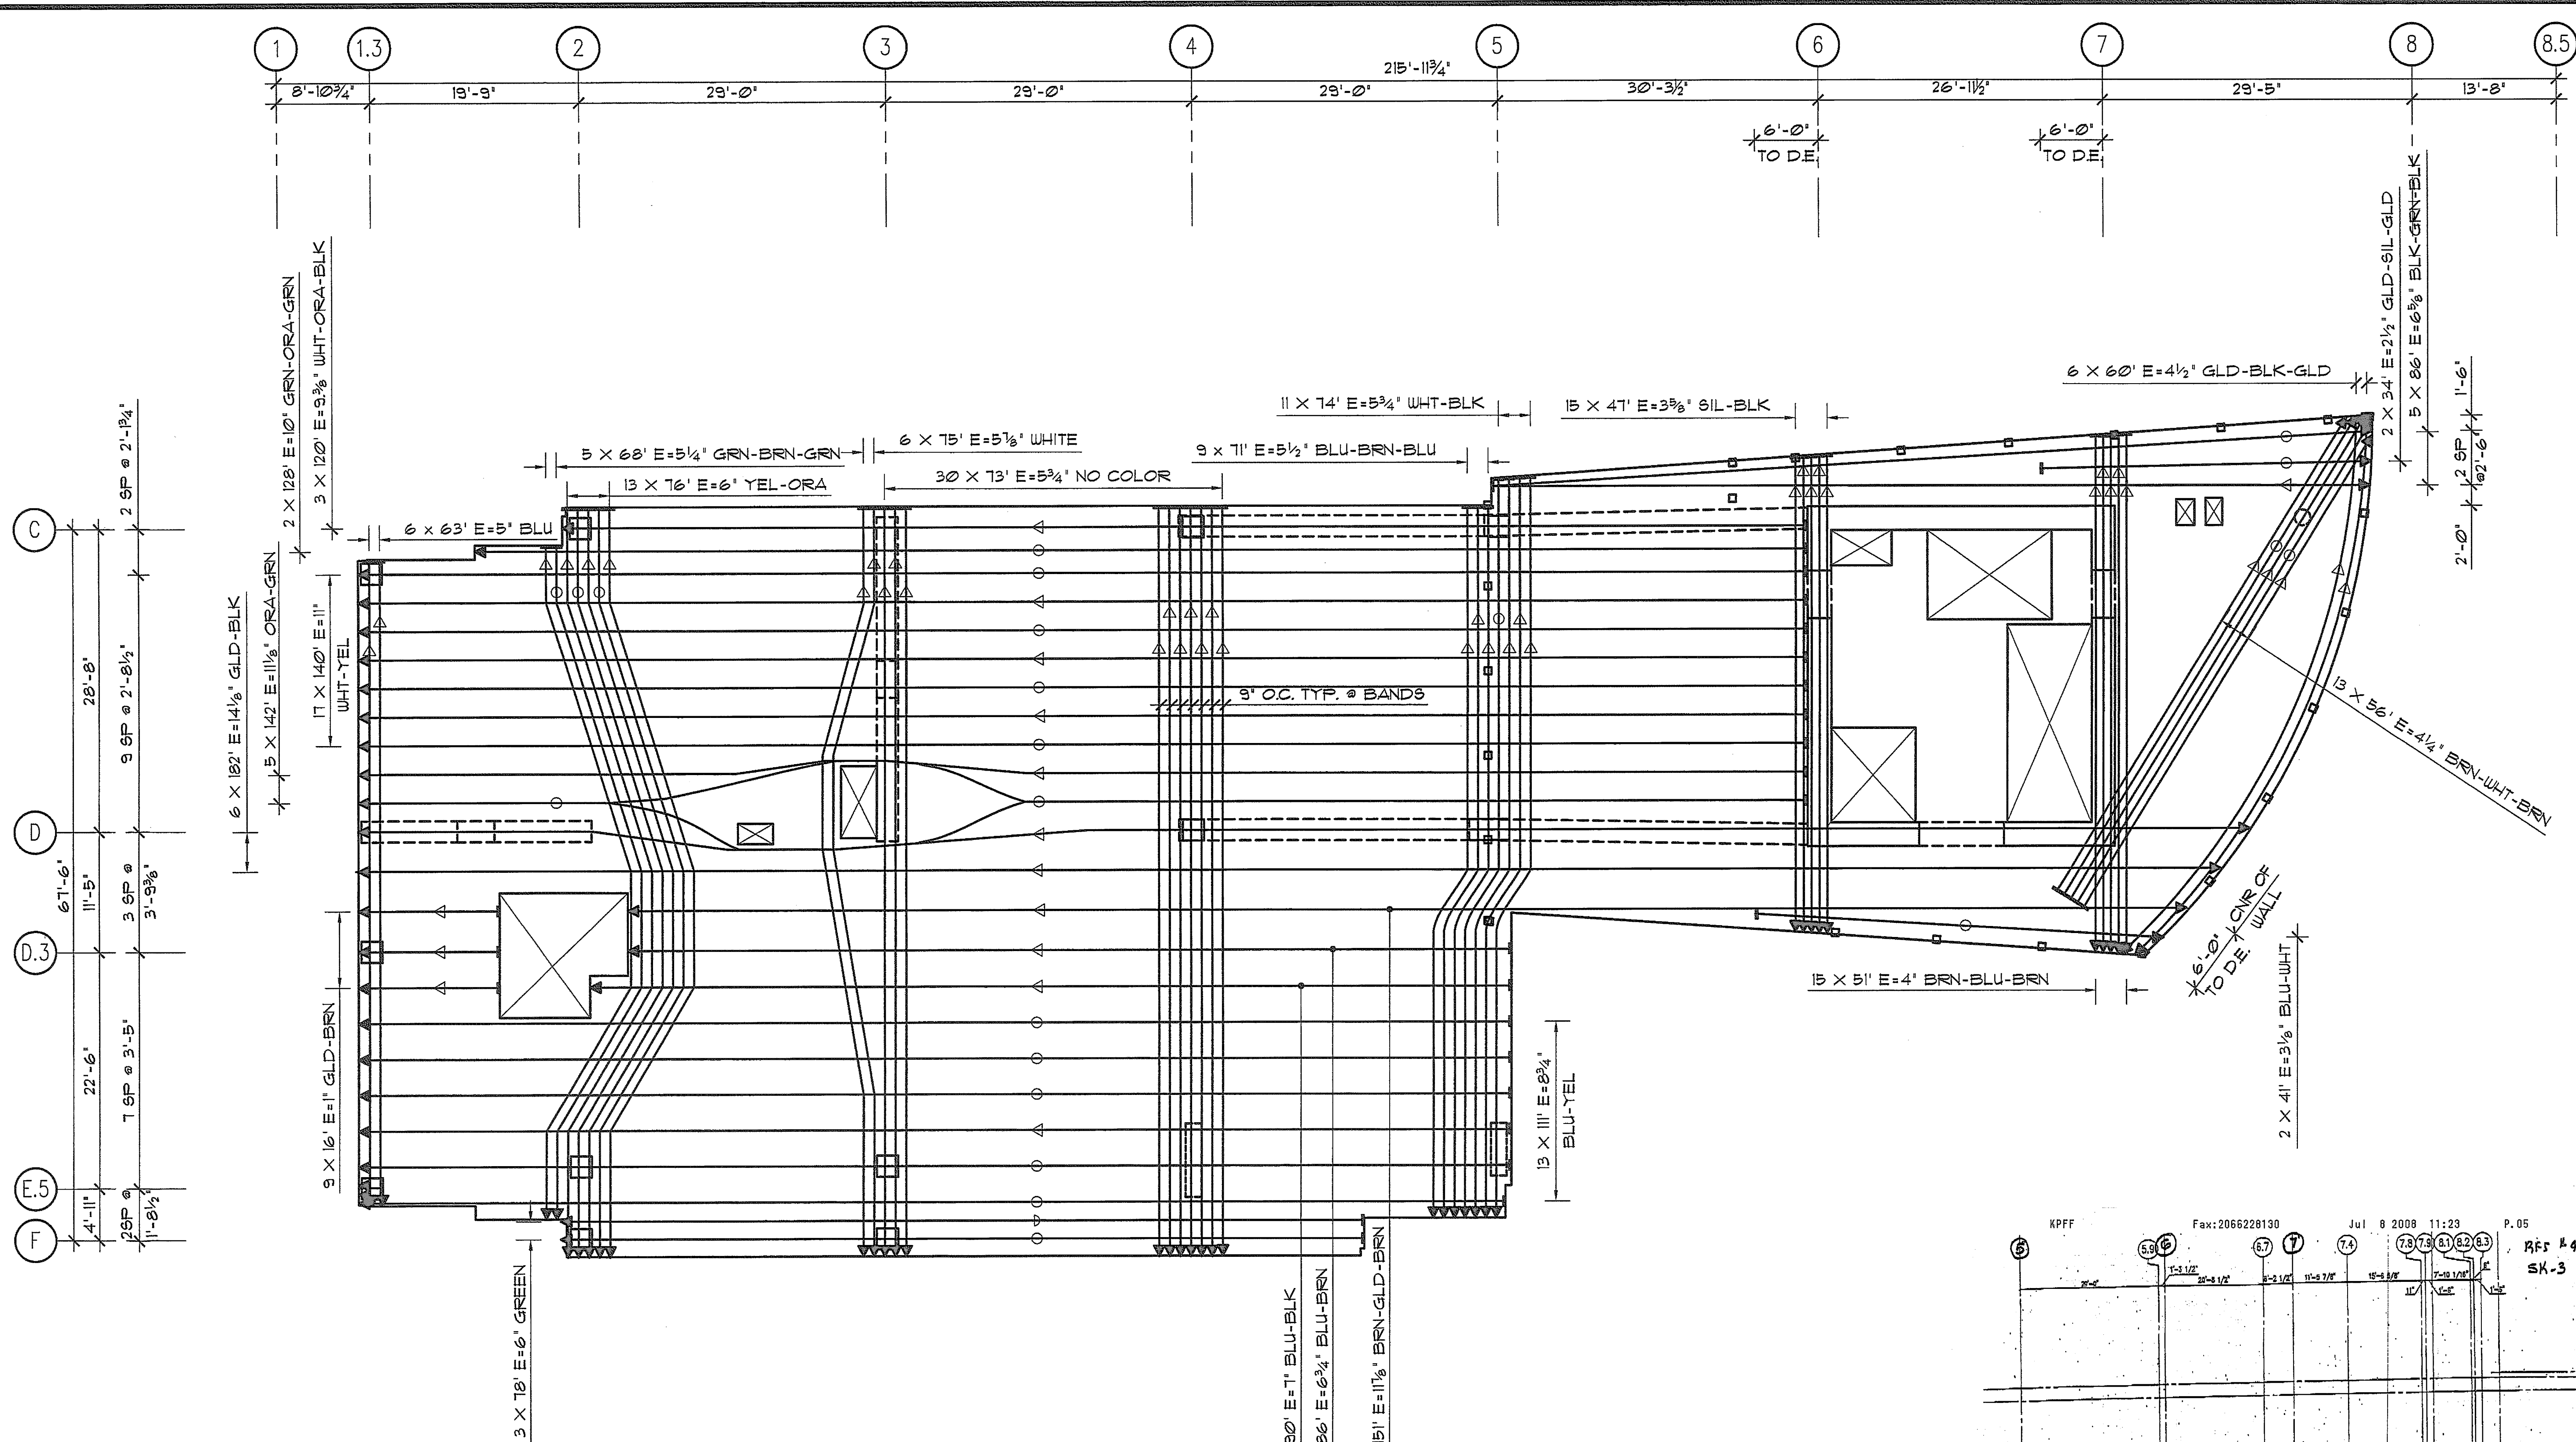


CITY OF SEATTLE
DEPT. OF PLANNING AND DEVELOPMENT
JUN 08 2008
APPROVED Subject to Errors and Omissions By
Martin Anich
MARTIN ANICH

☒ CONFORMS TO DESIGN CONCEPT
☐ CONFORMS TO DESIGN CONCEPT WITH REVISIONS AS SHOWN
☐ NON-CONFORMING
☐ REVISE & RESUBMIT
THIS SHOP DRAWING HAS BEEN REVIEWED FOR GENERAL CONFORMANCE WITH DESIGN CONCEPT ONLY AND DOES NOT RELIEVE THE FABRICATOR VENDOR OF RESPONSIBILITY FOR CONFORMANCE WITH DESIGN DRAWING AND SPECIFICATION. ALL OF WHICH HAVE PRIORITY OVER THIS SHOP DRAWING.
BY: *CCL* DATE: 6/2/08

03265-10-00
Review is for general compliance with the contract documents for this project only. Subcontractor or supplier is responsible for omissions, quantities, dimensions, field conditions, coordination with all trades, and information pertaining to fabrication processes or construction techniques. Review shall not relieve subcontractor or supplier from responsibility for errors, omissions or deviation from contract documents. Stamped submission does not constitute a change order.
Washington Hanover LLC
By: *Ng* Date: 6/17/08

REVIEW BY SAK CONSTRUCTION IS FOR DESIGN INTENT ONLY.
SUBCONTRACTOR AND/OR SUPPLIER IS RESPONSIBLE FOR DIMENSIONS, QUANTITIES AND FULL COMPLIANCE WITH THE REQUIREMENTS OF THE CONTRACT DOCUMENTS. REVIEW BY SAK CONSTRUCTION DOES NOT RELIEVE SUBCONTRACTOR AND/OR SUPPLIER OF THE RESPONSIBILITY REQUIRED BY THE TERMS AND CONDITIONS OF THE CONTRACT WITH SAK CONSTRUCTION.
☐ REVIEWED
☐ REVIEWED/REVISE AS NOTED
☐ DISAPPROVED/RESUBMIT
BY: *[Signature]* SAK SUBMITTAL

RECEIVED
JUN 20 2008

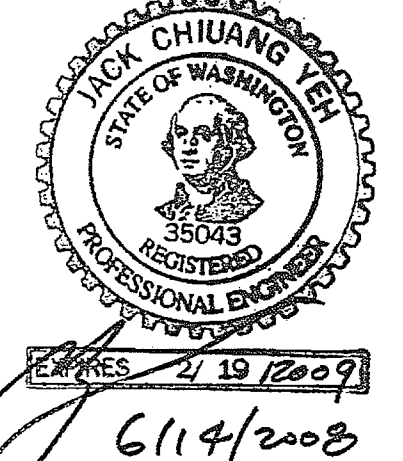

ISSUED FOR
JUNE 13, 2008
APPROVAL
RPS, INC. CLAREMONT, CA

- CABLE NOTES:
1) SEE SHT. #1 FOR GENERAL NOTES & TYP. DETAILS.
2) ALL SLAB ANCHORS SHALL BE LOCATED AT MID-DEPTH OF SLAB.
3) SLAB THICKNESS IS 8" TYP. UNO.
4) AT LEAST TWO TENDONS SHALL PASS THROUGH EACH COLUMN IN EACH DIRECTION.