

- SUPPORT NOTES:**
- 1) SEE DET. 4 FOR GENERAL NOTES & TYP. DETAILS.
 - 2) ALL SLAB ANCHORS SHALL BE LOCATED AT MID-DEPTH OF SLAB.
 - 3) SLAB THICKNESS IS 8" TYP. UNL.
 - 4) HEIGHTS ARE CHAIR HEIGHTS UNL. WITH A CCG
 - 5) 6# = SLAB BOLSTER

RECEIVED
AUG 31 2007
Dept. of Planning & Development
Plans Routing

RECEIVED
THE HANCOCK COMPANY

03866-6-0
REVIEW BY SAK CONSTRUCTION IS FOR DESIGN INTENT ONLY.
REVIEW BY SAK CONSTRUCTION IS FOR DESIGN INTENT ONLY.

ISSUED FOR
JULY 25, 2007
APPROVAL
CLARENCE CA



REV.	DATE	DESCRIPTION
1		
2		
3		
4		
5		
6		
7		
8		
9		
10		

SUPPORT BAR PLAN LEVEL 3
OLIVIAN TOWER

REINFORCING, POST-TENSIONING
SERVICES, INC.
210 NORTH STREET SE #2
ATLANTA, GA 30333
Phone (404) 525-3331 Fax (404) 525-3348

DATE: 7/25/2007
SCALE: 1/8" = 1'-0"
JOB: PT
SHEET: 3 OF 3

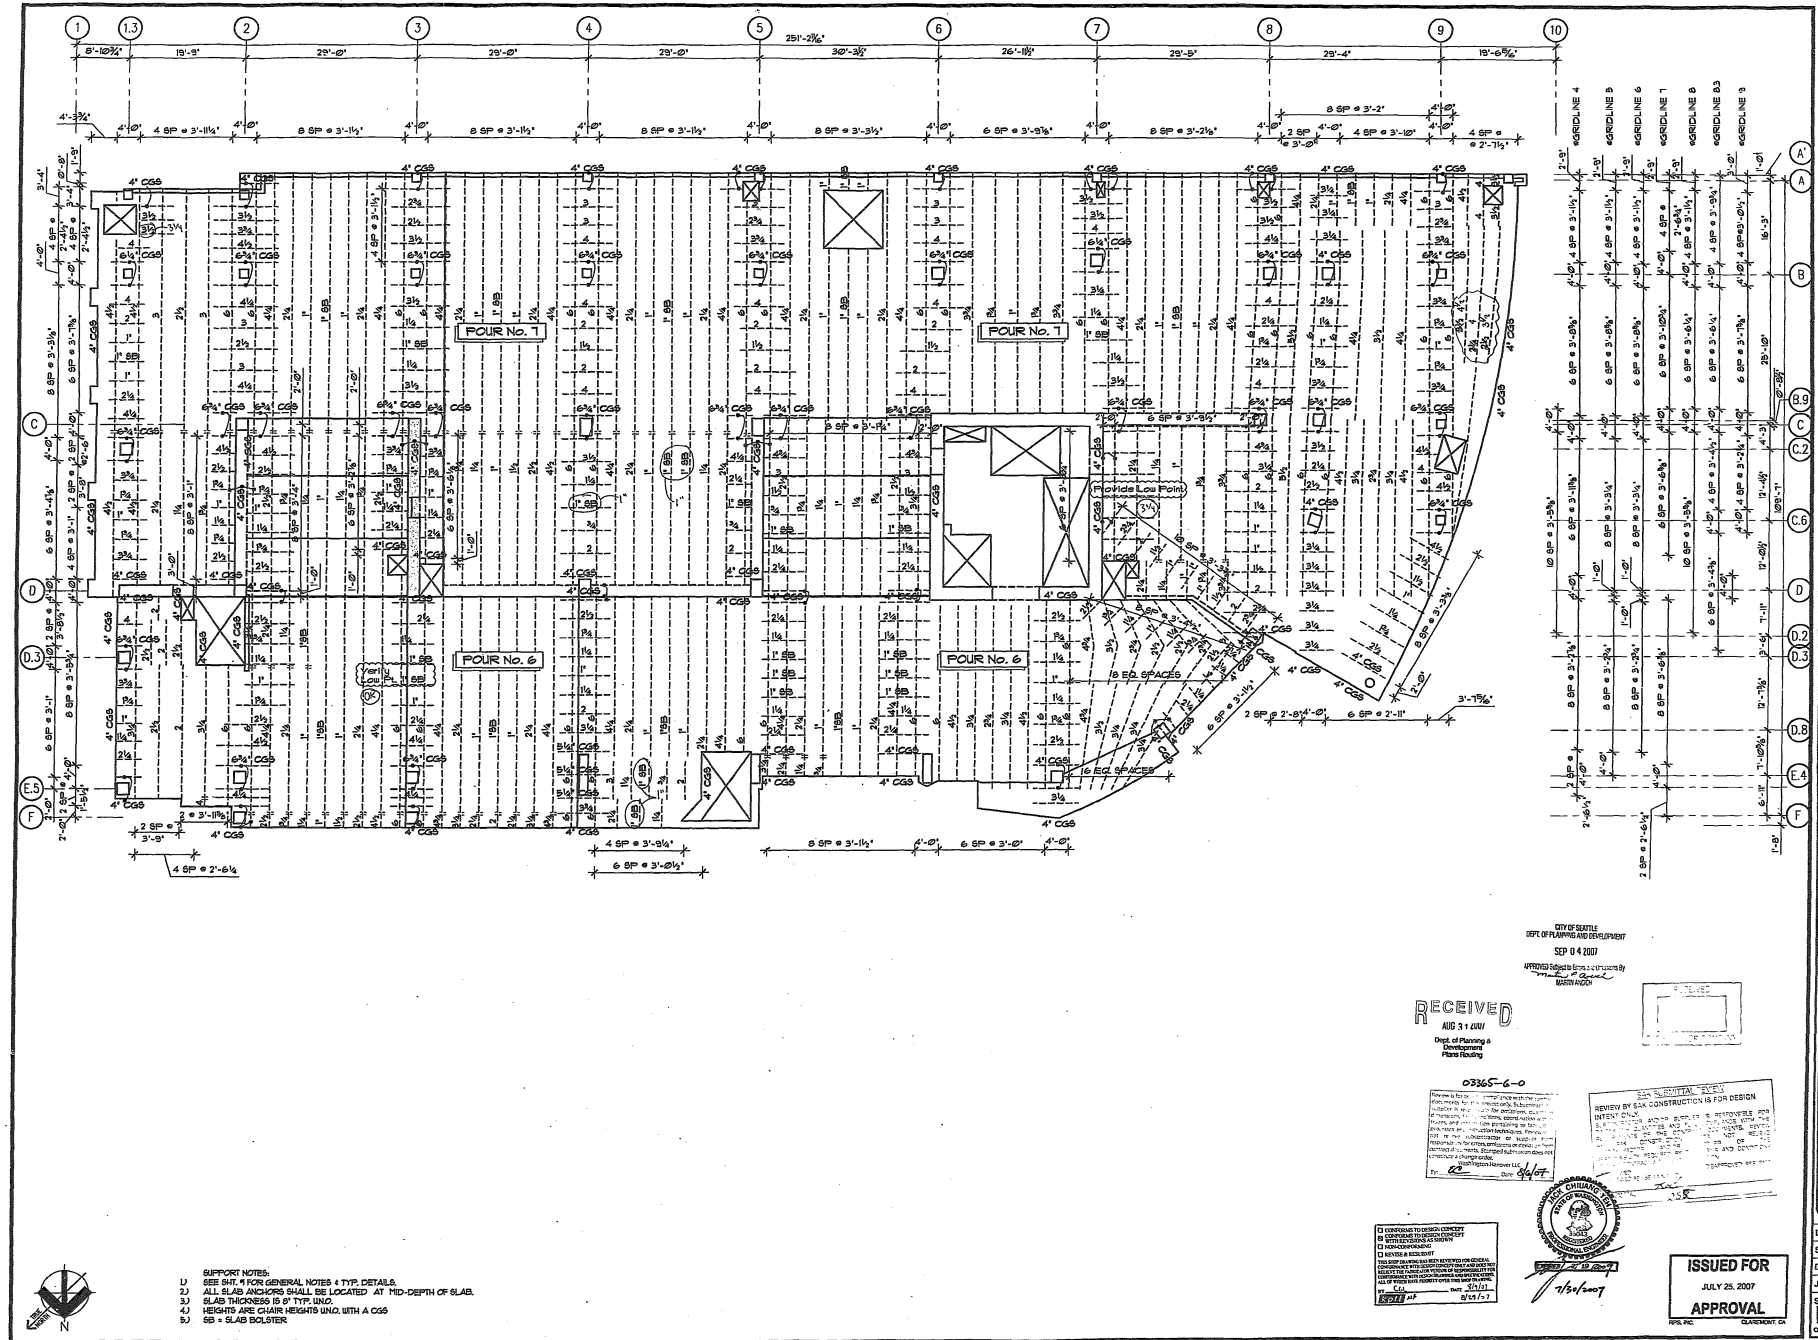

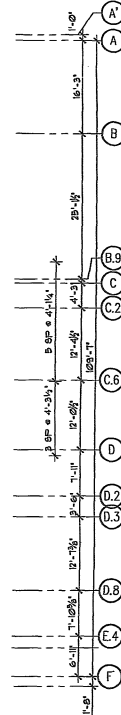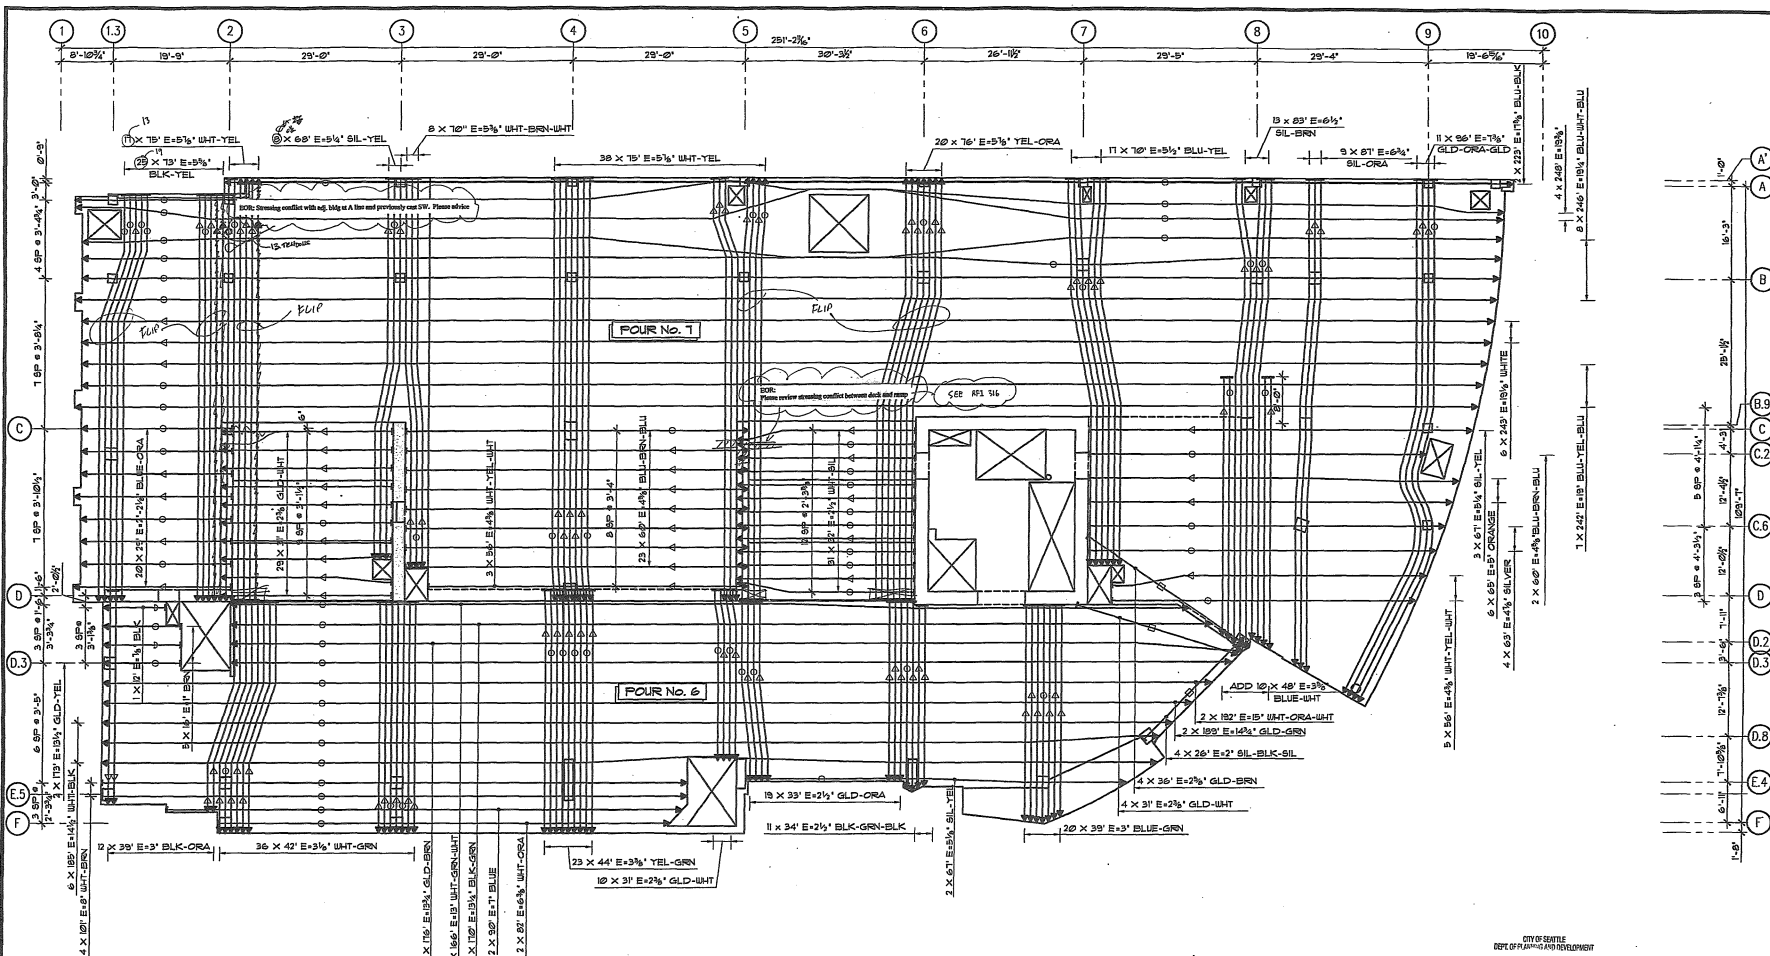

REV	DATE	DESCRIPTION

TENDON LAYOUT LEVEL 4

OLIVIAN TOWER

REINFORCING, POST-TENSIONING
SERVICES, INC.

716 10TH STREET SE #2
Atlanta, GA 30316
Phone (404) 555-3501
Fax (404) 555-3501



Date: 07/25/07
Scale: 1/8"=1'-0"
Drawn: THV
Job: 07043
Sheet: PT-11
of 6 sheets

CITY OF SEATTLE
DEPT. OF PLANNING AND DEVELOPMENT
SEP 04 2007
APPROVED SUBJECT TO REVIEW AND COMMENTS BY
MARTIN ANDERSON

RECEIVED
AUG 31 2007
Dept. of Planning &
Development
Plans Review

RECEIVED
AUG 31 2007
THE HANOVER COMPANY


07865-6-0
REVIEWED BY: [Signature]
DATE: 8/1/07
BY: [Signature]


SALES & FINAL REVIEW
REVIEWED BY: [Signature]
DATE: 8/1/07
BY: [Signature]



ISSUED FOR
JULY 25, 2007
APPROVAL
RPS, INC. CLARENCE, GA

- CABLE NOTES:
- 1) SEE DETAIL 4 FOR GENERAL NOTES & TYP. DETAILS.
 - 2) ALL SLAB ANCHORS SHALL BE LOCATED AT MID-DEPTH OF SLAB.
 - 3) SLAB THICKNESS IS 5" TYP. UNLESS NOTED OTHERWISE.
 - 4) AT LEAST TWO TENDONS SHALL PASS THROUGH EACH COLUMN IN EACH DIRECTION.

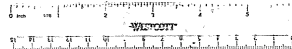

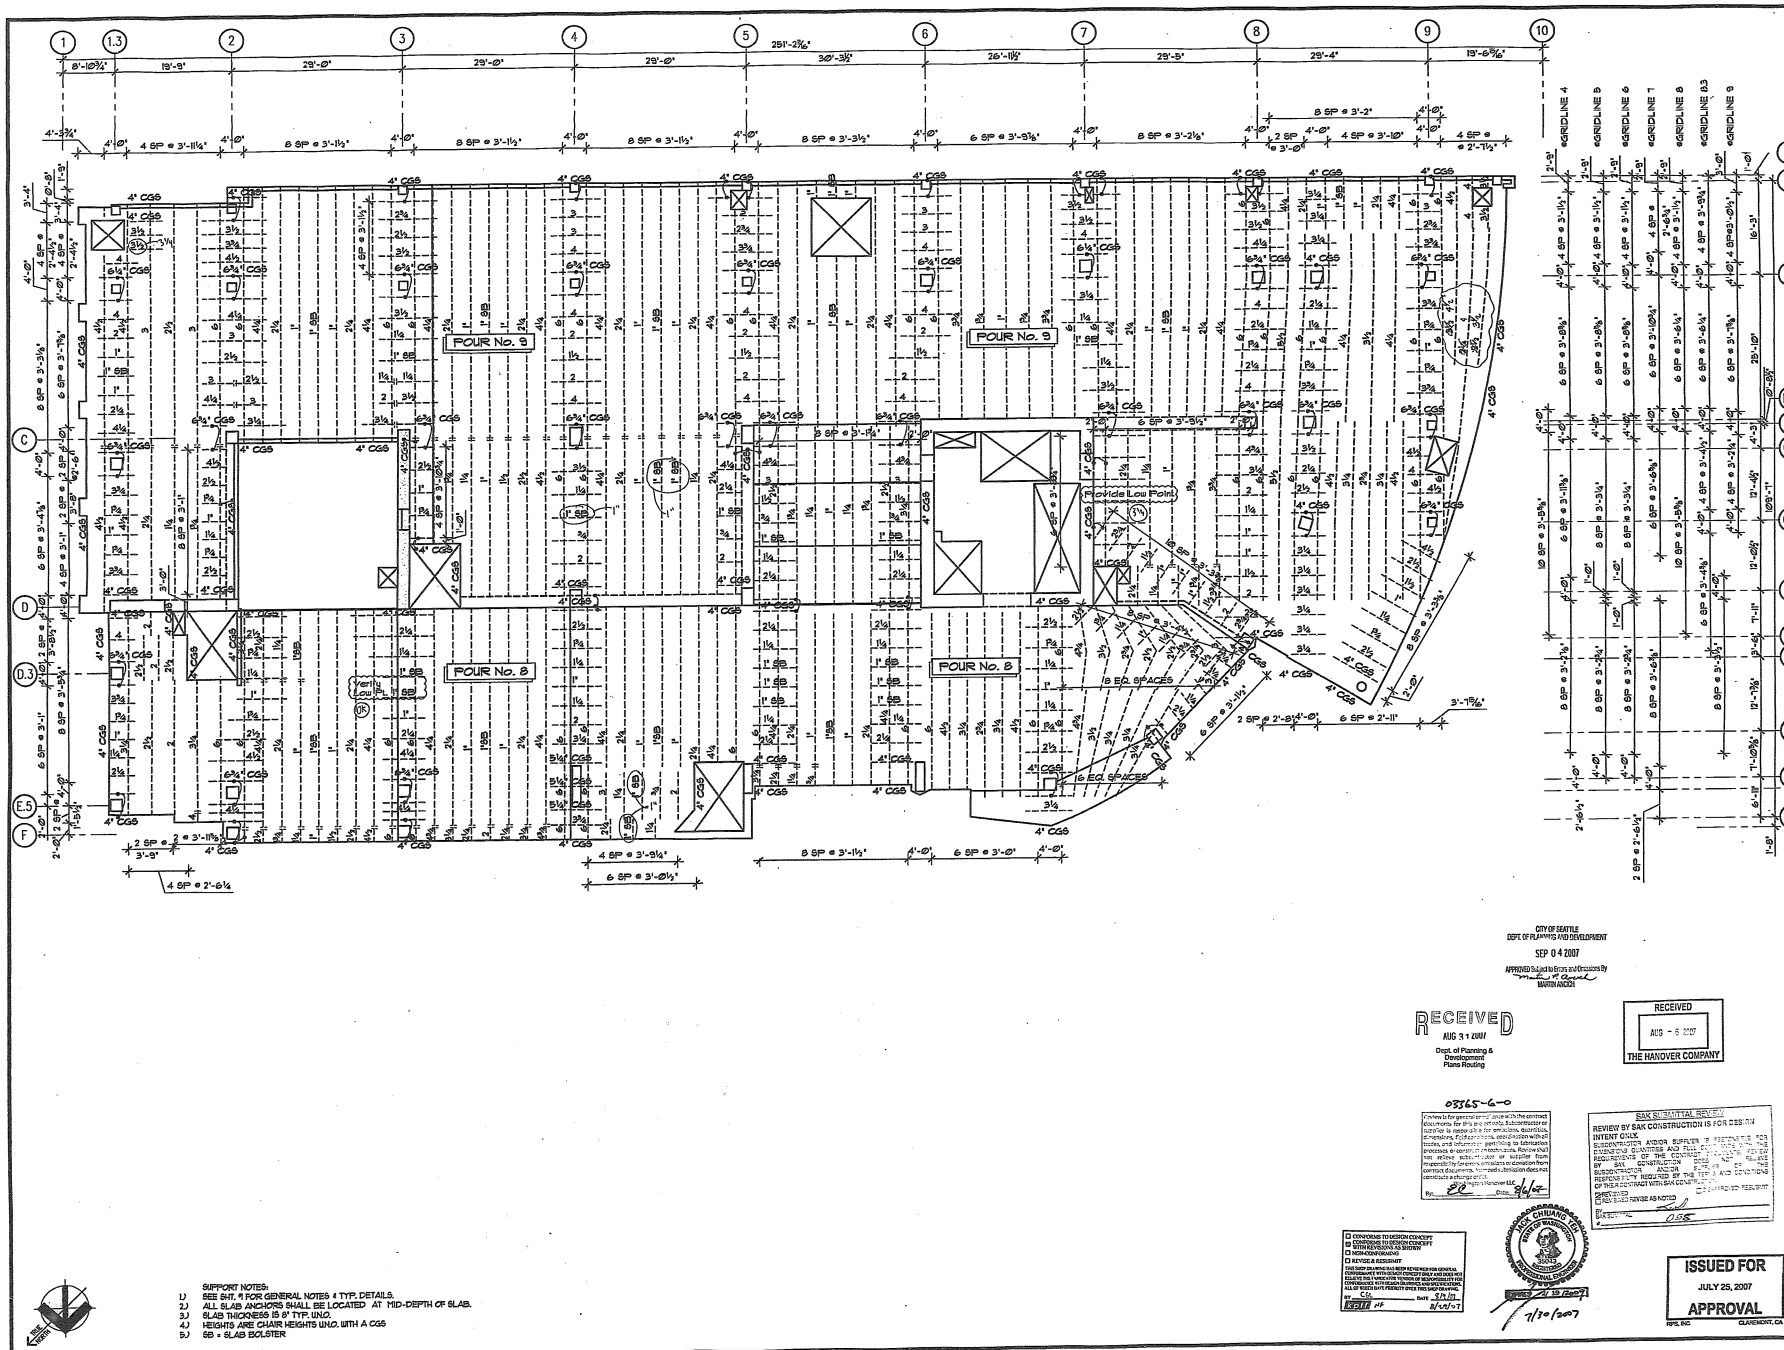

- SUPPORT NOTES:
- 1) SEE SHT. # FOR GENERAL NOTES & TYP. DETAILS.
 - 2) ALL SLAB ANCHORS SHALL BE LOCATED AT MID-DEPTH OF SLAB.
 - 3) SLAB THICKNESS IS 8" TYP. UNO.
 - 4) HEIGHTS ARE CHAIR HEIGHTS UNO, WITH A CGS
 - 5) SS = SLAB ISOLATOR

RECEIVED
AUG 3 1 2007
Dept. of Planning & Development
Plan Review

RECEIVED
AUG 5 2007
THE HANOVER COMPANY

03765-6-0
Review for general use of the system...
APPROVED FOR GENERAL USE
DATE: 8/1/07

REVIEW BY SAC CONSTRUCTION IS FOR BEST...
INTENT ONLY
SAC CONSTRUCTION
DATE: 8/1/07



ISSUED FOR
JULY 25, 2007
APPROVAL
CLARENCE, CA

SUPPORT BAR PLAN LEVEL 5
OLIVIAN TOWER

REINFORCING, POST-TENSIONING
SERVICES, INC.
715 NORTH STREET SE #2
KNOXVILLE, TN 37903
Phone: (615) 595-5940
Fax: (615) 595-5941

DATE: 07/25/07
Scale: 1/8"=1'-0"
Drawn: TMV
Job: 07043
Sheet: PT-12

